

C.S. # 1387

College Crest Addition
Block 17

F.B. 85-59

59

1387

Robinson's


27TH

N45' 10f Lot 17 College Crest
Elizabeth P. and Jennie B. Ritchie
June 11, 1938

60

40'

• 1 1/2" pipe
on cl. line

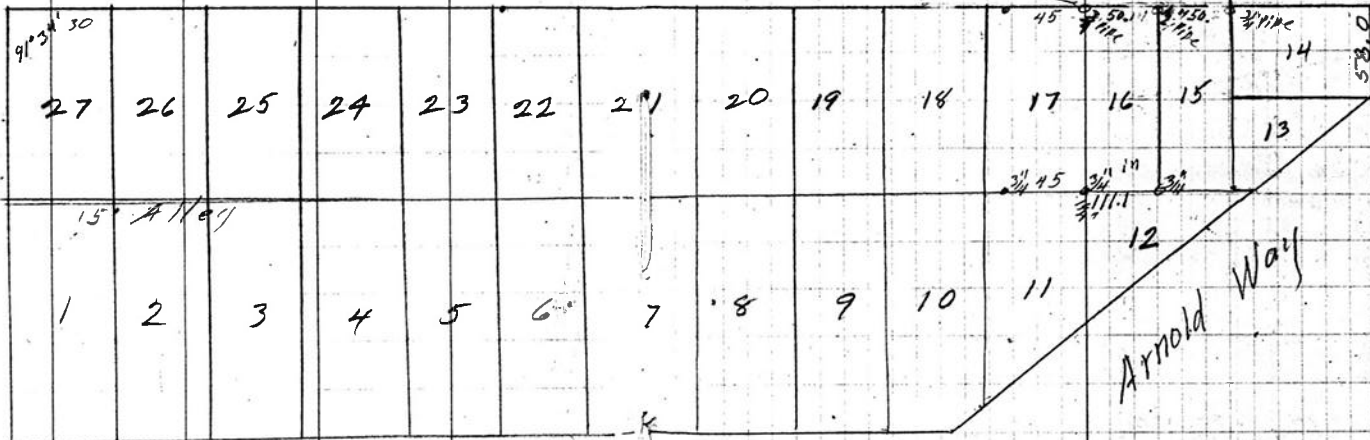

Teitch

STREET

530.0

34'

60'

40

538.0

Arnold Way

26TH

STREET

530
51.52
478.48

59

1387

Robinson's

27TH

N45' 10" Lot 17 College Crest
Elizabeth P. and Jennie B. Ritchie
June 11, 1938

60

Toitch

STREET


530.0

34'

60'

60'

40'

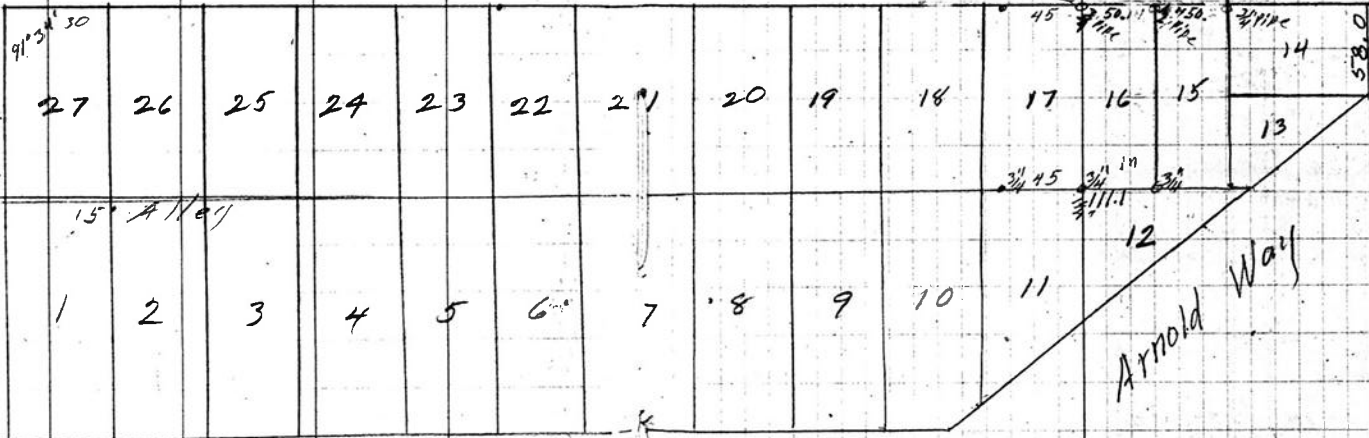

40'

• 1 1/2" pipe
on cl. line

26TH

STREET

530
51.52
478.48