



C.S. # 1396

See notes in file

F.B. 85-63

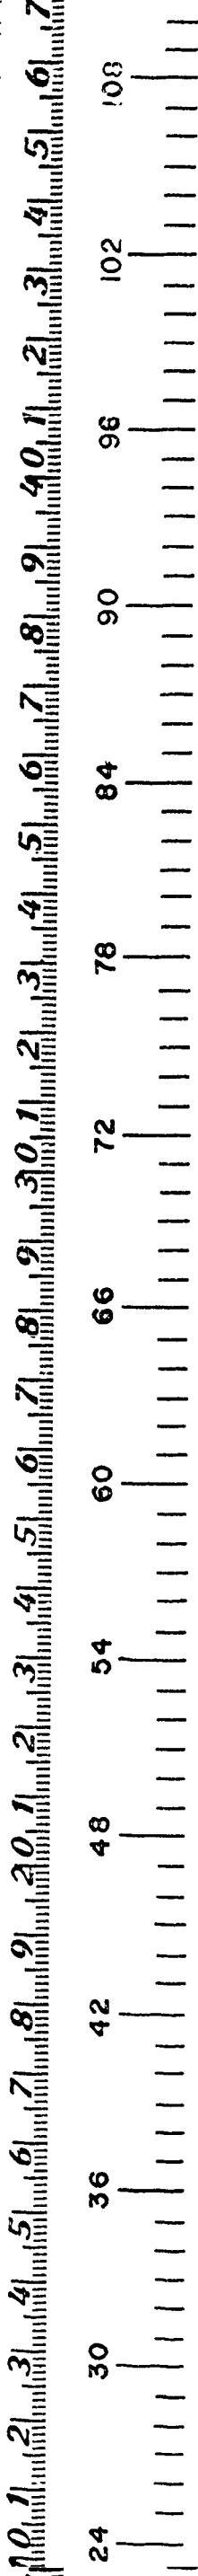

63

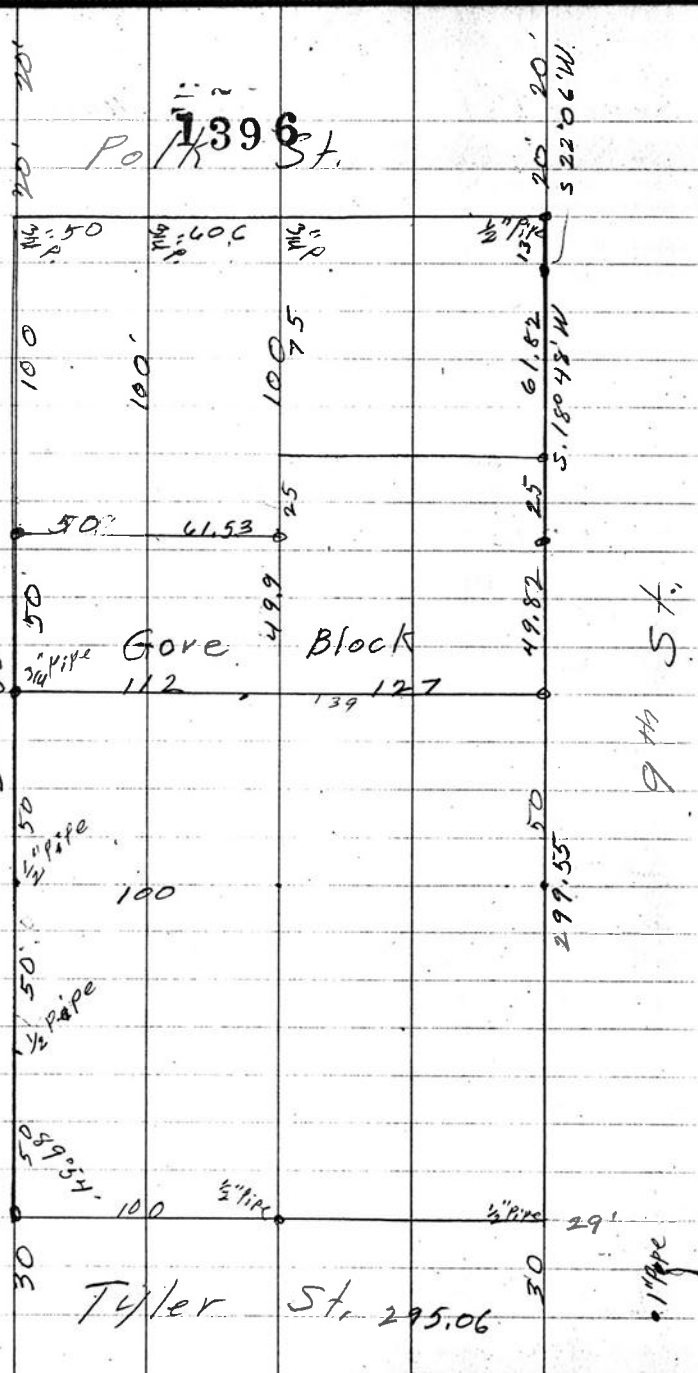

Helpers
Adrian Seits
J.W. Both

Aug. 20, 1938

64

F. C. Brown


63

10 St.

Polk St. 1396

Gore Block

Tyler St. 295.06

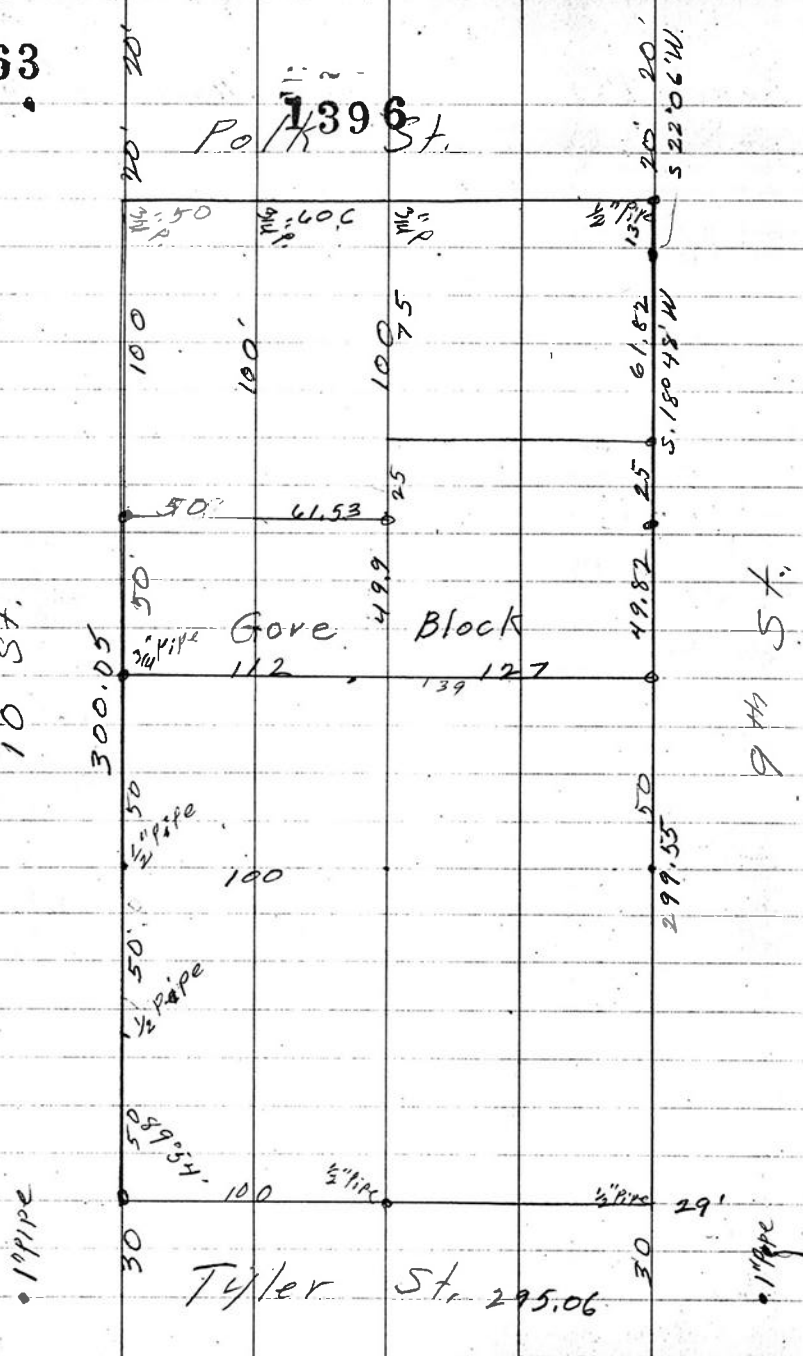

Helpers
Adrian Seits
J.W. Bath

Aug. 20, 1938 64

F. C. Brown