

C.S. # 1413

Original Town of Marysville

Block 10

F.B. 85-73




73

1419

Adams St.

57th St.

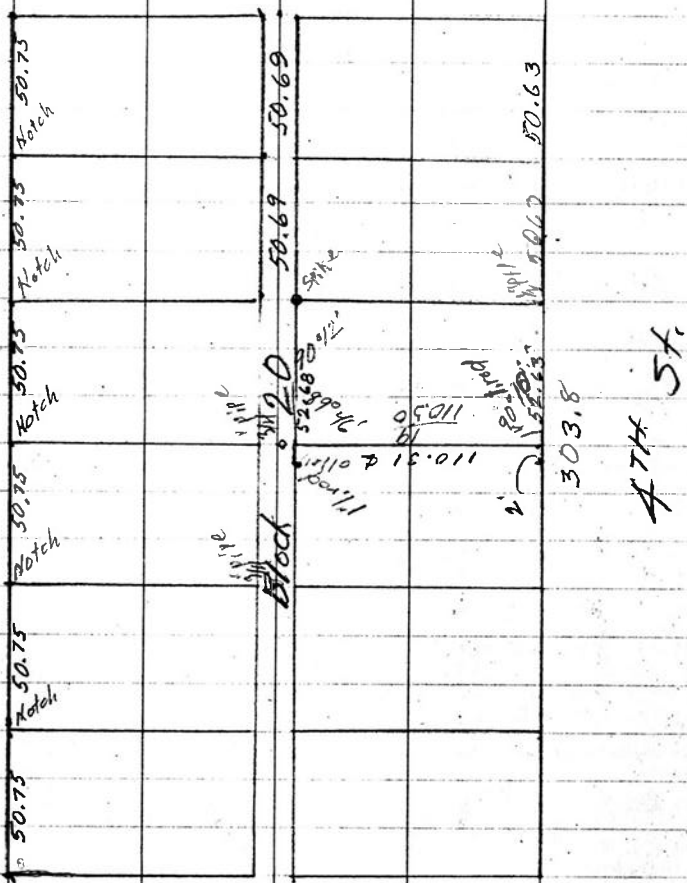

Washington St.

74

Jan. 4, 1939.

Fred Archibald