

C.S. # 1440

Country Club Heights

F.B. 63-76

12-5

Book 63.


FIELD BOOK

361A

76

July 27, 1959.

1440 added 2/20/2024  
ESA

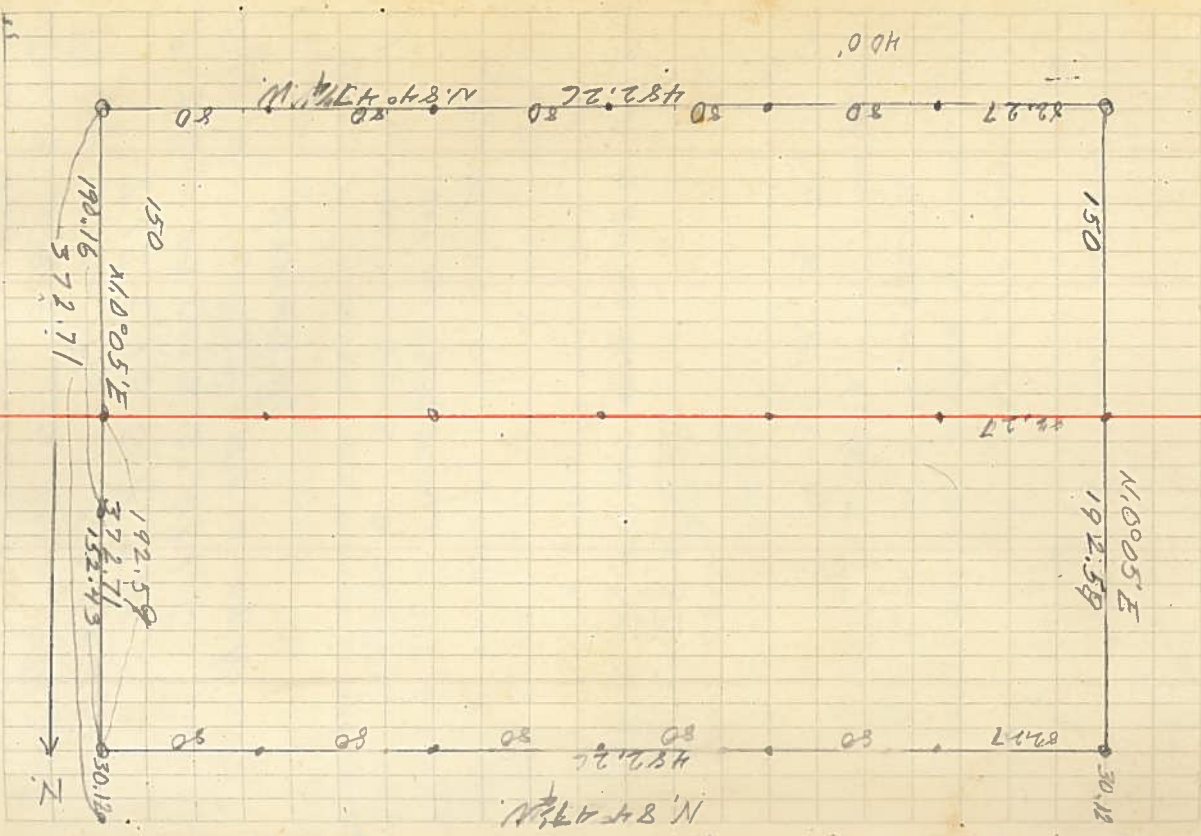

75

3927  
1  
150  
1927  
3727  
372.7