

C.S. # 1518

See notes in file

F.B. 85-111



Book 85.

DICTIONARY

ENCHYRION

FIELD BOOK


No. 40116

111 1518

Survey for Delbert Moore  
Between Western Ave & Philomath Road  
For Elevations & Objects as  
demanded by Architects

Sta	T	H.I	Elev
Sewer Flow Line		83.09 <del>84.09</del>	71.97
Walk to lot		11.12	76.25
V 7 Lot		6.84	76.53
5-5.7		6.56	78.54
5-5.10 W.T		4.55	77.3
5-5-20 W T		4.75	77.9
5-5-30 W		5.22	77.5
5-5-40 W		5.64	77.0
5-5-F		6.09	76.3
A 50		6.75	75.9
A 40		7.23	76.5
A 30		6.54	76.8
A 20		6.26	77.1
10		5.94	77.6
A 0		5.49	78.0
B 0		5.09	77.9
10		5.21	77.6
20		5.44	77.1
30		5.98	76.8
40		6.30	76.7
50		6.38	76.1
		7.0	

Power Pole  
8' 5.6' 3 1/2 W  
57'-S. 57° 06' 20" W  
from L. Lot  
Power Lines to Ho. E of lot

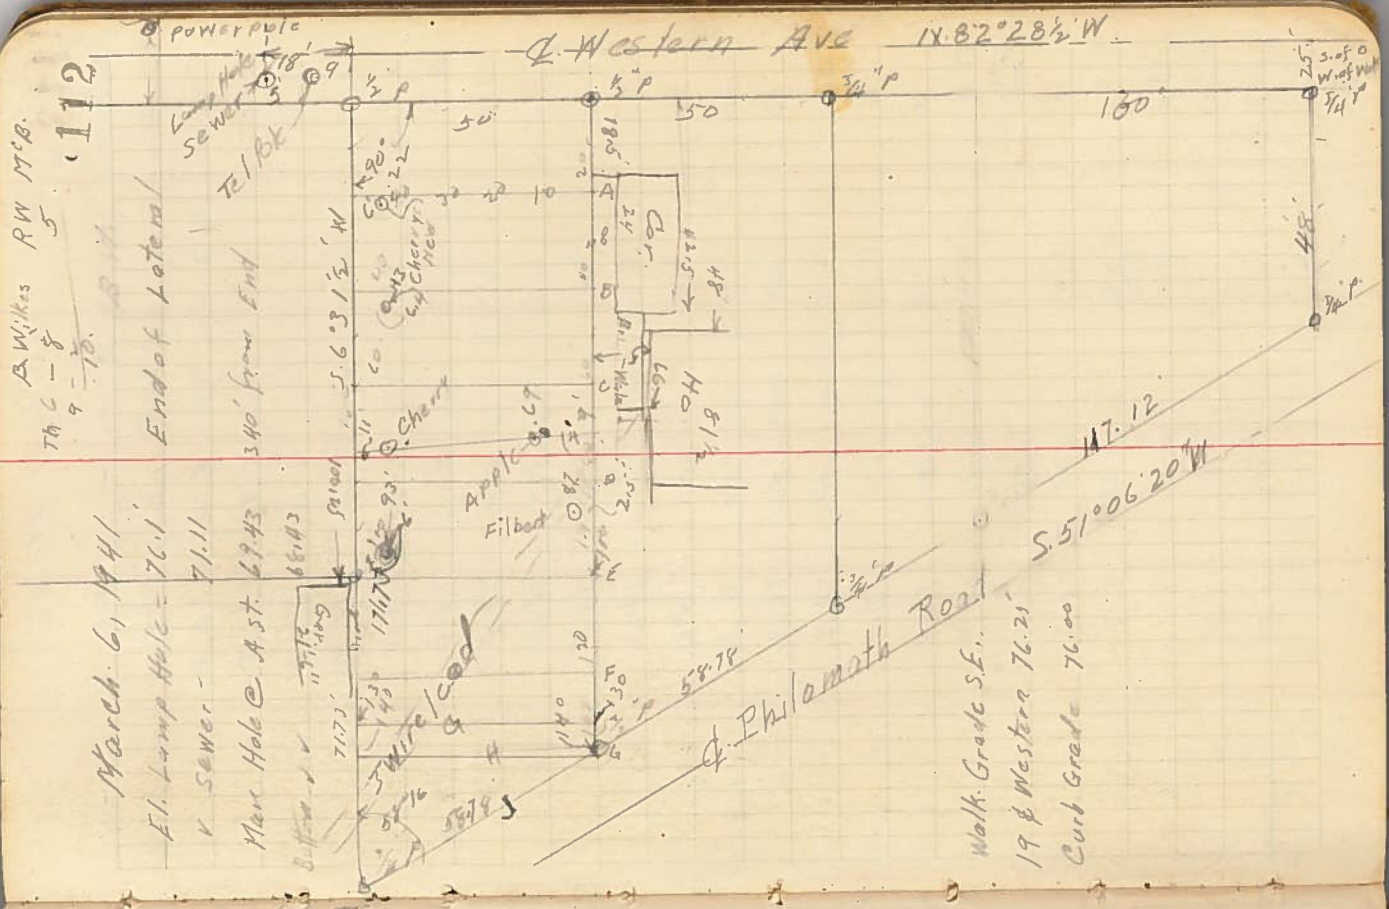

A. Wilkes RW M.B.  
70 9-8  
70  
(112)

March 6, 1941  
E.L. Lump Hole = 76.1  
V Sewer = 71.11  
Man Hole @ A St 67.43  
68.43

End of Lot  
340' from End

5.6' 3 1/2' W

Cherry  
Appl. & Filbert

58.78  
58.78

71.75  
71.75

Delbert Moore

Sta	T	E	8300	F/ey
C 50	8309	722	9.9	83.1 75.2
C 40		662	7.5	75.1
C 30		630	7.1	76.0
C 20		580	6.5	76.6
C 10		541	5.9	77.2
C 0		529	5.7	77.4
D 0		511	6.1	77.1
10		514	6.1	77.1
20		519	6.5	76.6
30		6.4	7.3	75.8
40		6.4	7.8	75.3
50		7.51	8.2	74.9
E 50		7.37	8.5	74.8
40		6.80	8.50	74.6
30		6.50	6.4	76.7
20		6.10	6.9	76.2
10		5.72	7.4	75.7
E 0		5.18	7.8	75.3
F 0		5.65	8.1	75.6
10		6.20	8.4	75.7
20		6.60	8.40	74.69
30		7.0	8.02	75.07
40		7.60	7.7	75.47
50		7.70	8.0	75.1
			8.1	75.1
			8.1	75.0
			8.1	74.9
			8.1	74.7
			8.1	74.6

20'S HSD  
 1.40 f JFR  
 31.75 HSD  
 3' N J 7'  
 3' N J 15  
 3' N J 25  
 3' N J 35  
 3' N J 45  
 3' N J 53  
 8.40 5 of L  
 8.02 2 of J  
 7.7 2.5 J 10  
 8.0 2.5 J 20  
 8.1 2.5 J 30  
 8.1 4.5 J 40  
 8.1 5 J 50  
 J 55

BH Rem

Sta	T	E	8300	F/ey
G 50				83.1 75.2
40				75.1
30				76.0
20				76.6
10				77.2
0				77.4
A 0				77.1
10				77.1
20				76.6
30				75.8
40				75.3
50				74.9
20'S HSD				74.8
1.40 f JFR				74.6
31.75 HSD				76.7
3' N J 7'				76.2
3' N J 15				75.7
3' N J 25				75.3
3' N J 35				75.6
3' N J 45				75.7
3' N J 53				74.69
8.40 5 of L				75.07
8.02 2 of J				75.47
7.7 2.5 J 10				75.1
8.0 2.5 J 20				75.1
8.1 2.5 J 30				75.0
8.1 4.5 J 40				74.9
8.1 5 J 50				74.7
J 55				74.6