

C.S. # 1545

Avery's Addition  
Block E

F.B. 87-11

Book 87

CITY &

SUBDIVISIONS



ENGINEERS

FIELD BOOK


No. 4047

11 39.8

1545

Block E. Avery's Add.

B. Street

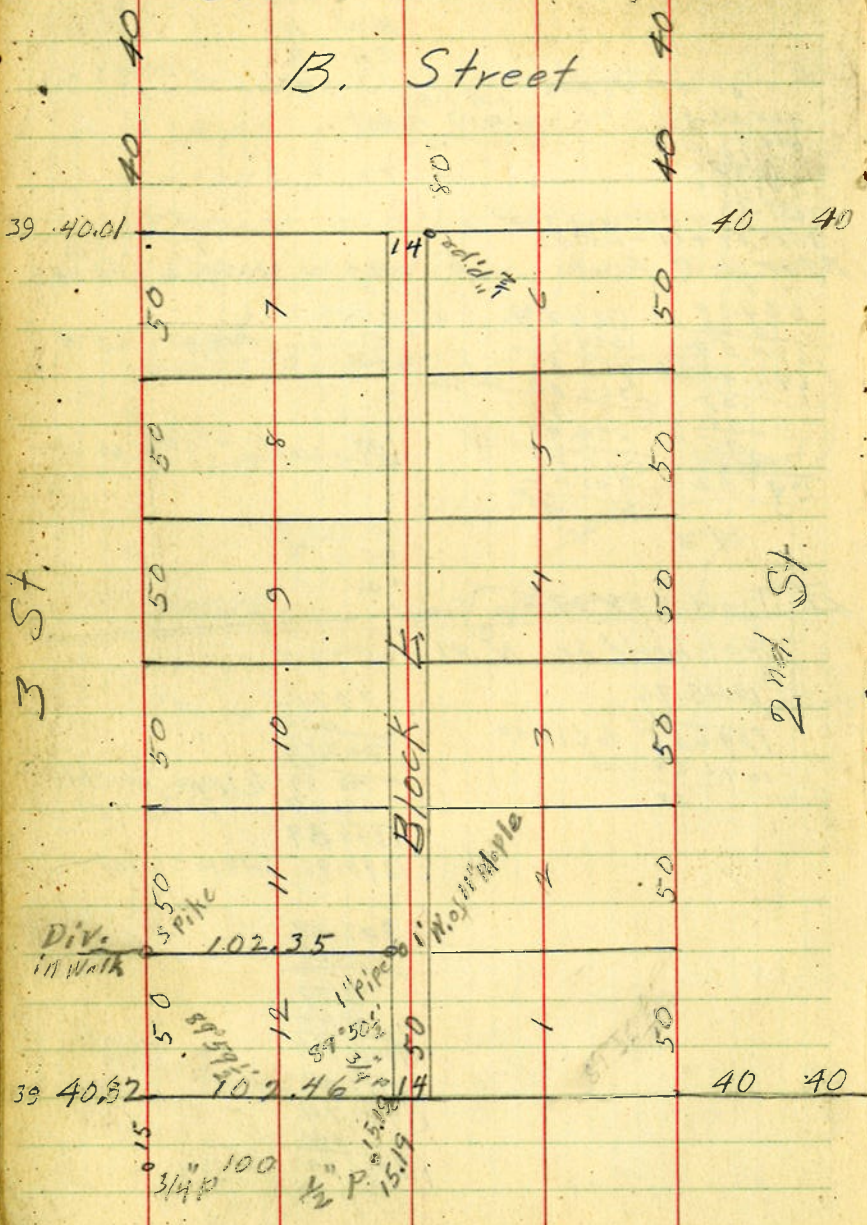

Fav

12

John Mackman Oct 24, 1941

beg. at 3/4" pipe on N. of B. St. +  
E. of Alley B.S. to Ⓞ on N. of Blk.  
8' W. of pipe = 1" 16"