


C.S. # 1624

Hardcopy 14-5 # 18

also see notes in file

F. B. 88-19

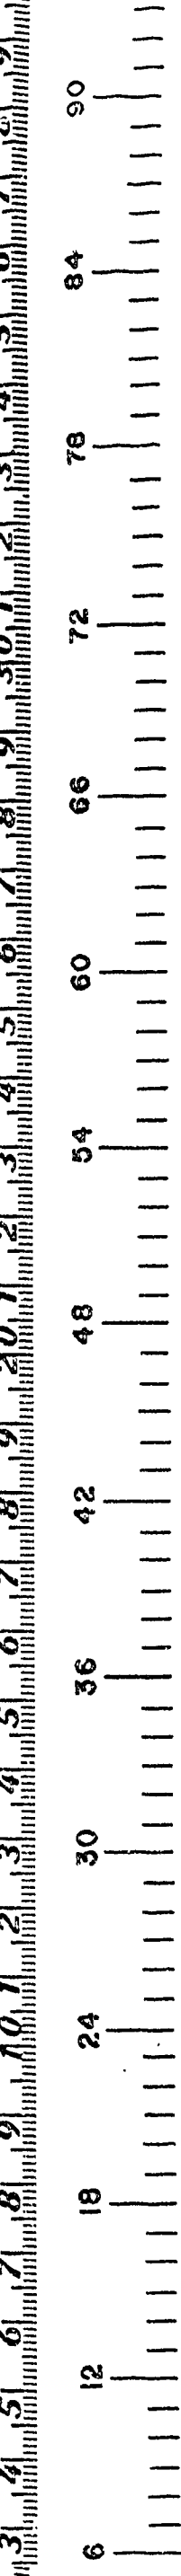

back to Δ 3

N. 0° 04' E.

6	LR 29'	3.701	offset 031 E
	LL 272'	5.828	offset
7		5.343	089 W.
		+1.191	

Set 3/4" G. pipe

N 89° 30' W
Ash 15' S 89° W. 1.39616° 30' .286
Fir 9' N. 91° 20' W. 2.224

8		7.397	
9		4.260	offset
	LR 99° 57'	256	.252 E,
	1 1/4" pipe set over former iron		

	00944	7	11.171	11.171	43.696	
	3701	25.089368	7.635	11.362	3.727	
	844		.00309	3.727		
	5908		22905	7.635	55.058	39.995
	2532		22905	59.867		3.701
	23644		2313405	191.73696		11.171
03	123644		17279	54850		54.867
	98496		2504	24.722		7.397
	256		103674	79.572		4.260
	59087		82395			66.524
	492480		34558		7.397	.049
	176992		071923424		1.206	66.480
	2521497		00303 = 104		4.260	13.300
	offsets		66453	201000	11.466	7.9.780
	.007 E.		197359		1.044	
	.031 E.		164100		11.422	
	.038 E.					
	.089 W.		3727		5.8928	E 10.01.30.02
	.051 W.		.008		1 1/2" pipe	
	.252 E.		.229816		Ash 105° 8' 20" W.	395
	.201 E.				" 125° 29' W.	936
	.038 E.		.217 E.		" 145° 19' E.	412
	.030 W.		.023		89° 45' N	
	.008 E.		.194 E.		N. 0° 14' E	
			.059		89° 33' 2	
			.135			
	47.423					
	.00303					
	142269					
	142269					
	14369969					
	.008					
	.135		5.000			
			.135			
			4.865			