


C.S. #1633

See notes in file

F.B. 102-4

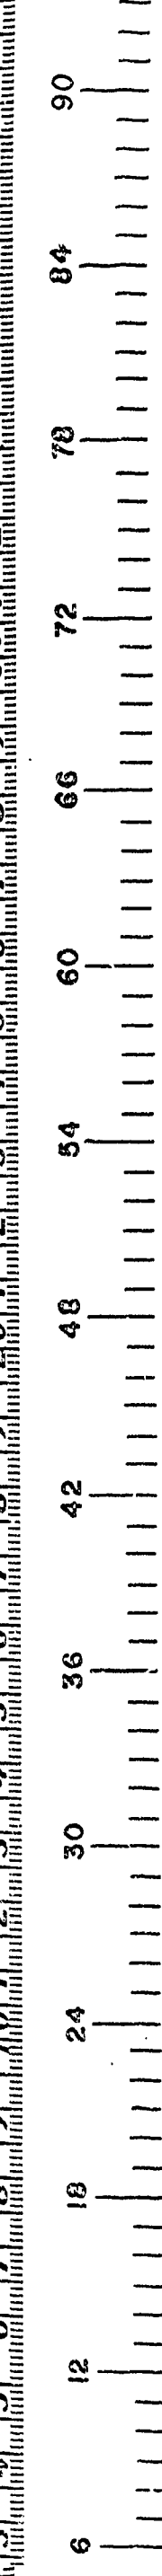

5 Back to O or 3/4" pipe
 Recst: 1-2-33
 N. 26° 56' W. + 8' 12" .6215 offset 2786 W.
 Oak 4" S. 44° 08' E. .608 Sept. 25, 1913
 Fir 11" S. 20° E. .270 P.M. Beardley
 " 18" S. 79° W. .190
 Maple 4" N. 55° 15' W. .374

S. 88° 13 1/2' W.

.89153
 615
 445765
 89153
 534918
 54829095

.45295
 615
 226475
 45295
 271770
 27856725

.98978
 621
 98978
 197756
 593968
 .61465338