


C.S. # 1645

County Addition

Block 10

F.B. 87-79

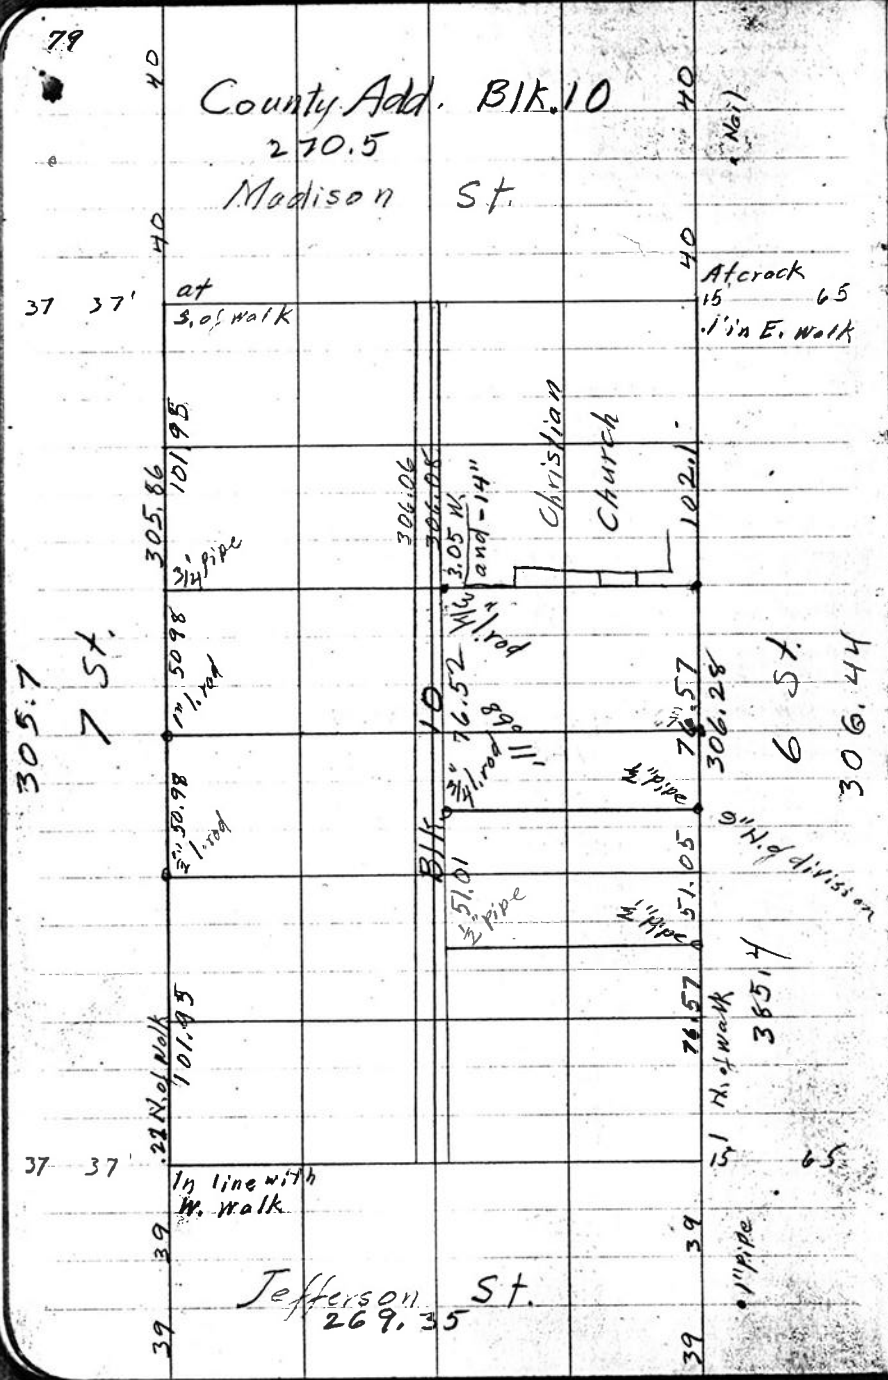

For Mable A. Jackson Nov. 16, 1943
1645
W.C. Galloway
C.W. Raber

6	1305.86	6	1306.08
	50.98		251.013
			28.507
			78.52

6	1306.28
	51.098
	25.524
	76.572