

90
84
78
CHAINS

C.S. # 1657


Dixon's Addition
Block 6

F.B. 87-83

1657

Block 6 Dixon's Add.

Tyler

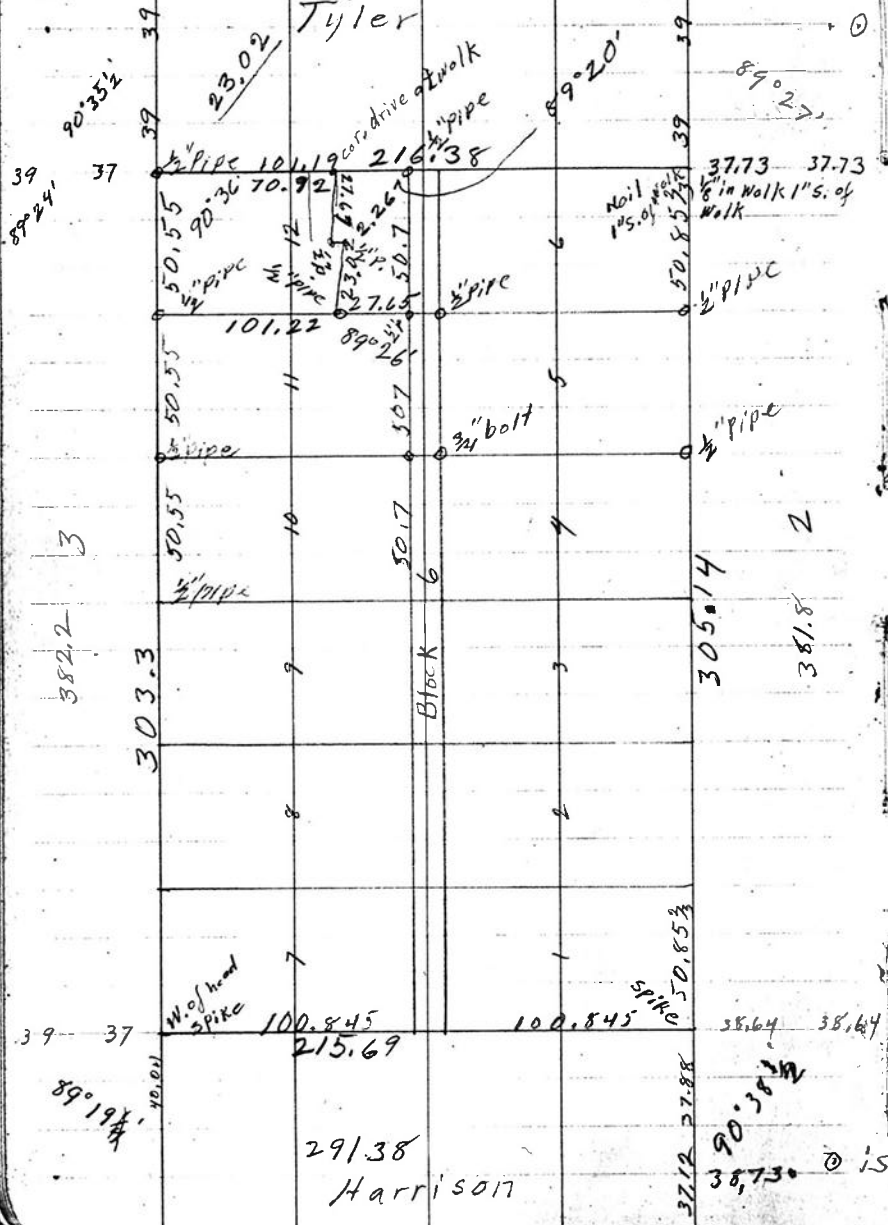

291.38
Harrison

Elsie Linn Rodin and
For Sven E Rodin Feb. 14, 1944

is 1 of an inch E. of hole in lid

		89°19'
		90°38 1/2'
		89°27'
		90°35 1/2'
		366 00'
3864		
37.73	238	
	91.00	
3818	7634	
	14640	
	11434	
	31420	
57.84		
23.5		
303.04		
11364		
7576		
090.1544		
2	216.38	291.38
	108.19	137.00
		254.38
		38.73
2	215.69	215.65
	107.845	102.425
		37.00
		139.825
	50.85 1/2	
	2	
	101.71 1/2	6
		305.14
		50.85 1/2
		6
		303.3
		50.55
		50.86
		2
		101.41
		50.70 1/2

38.64 38.64
90°38 1/2'
38.73 is at edge of hole N45° E.