


C.S. # 1672

Hardcopy 10-4 #26

also see notes in file

F. B.

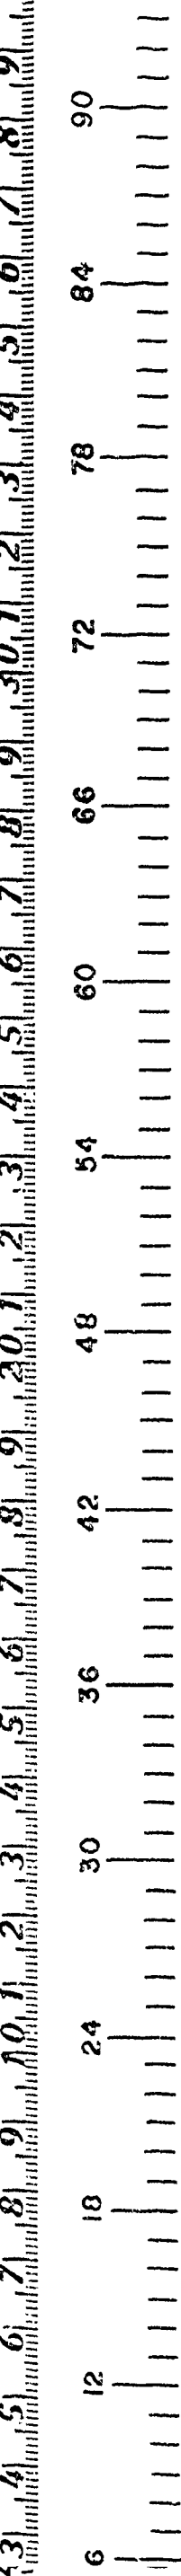

69

1672

County Survey 22

Came to 1" pipe 2.608

N. 0° 09' 1/2" W

N. 70° 26' E.

set 3/4" pipe .321

1

+ 9° 30' 3.340

2

+ 3° 05' 1.4295

3

0° 1.152

-.050

Set a 3/4" pipe

4

- 2° 45' 2.8302

5

- 10° 40' 2.140 -.008

Striking S. 1° 12' E. .073 of 1" pipe

(Change 1" pipe -.008 and

6

.2517 set a nail then 9 mi. 661

Striking N. of gun 661. 0217

S. 6° 08' E. to 1/2" pipe s. of road

N. 0° 28' W. + 13° 20' 3.168 = 3083

7

Back to Δ 3 -.030

8

S. 6° 08' E. - 8° 2.709

9

- 9° 45' 1.654

10

- 15° 40' 3.118 + 1.04 for Δ on tangent

(set 1/2" pipe .003 N.)

set 3/4" pipe .002 N.) and + .403

front tangent

.3749 = 24.74'

on 6° curve =

32 = 005 on

For Dr. A. P. Howells

May 27, 1944.

98629	74318	321	6799.58
334	79835	303000	2480.94
394516	173	262954	318.66
295887	279565	200460	
275887	599230	188636	
329420.86	99885	118270	
282	14279265.9	5873	3294
258655	98272	1032	1.427
799080	214	5843	1.152
197770	393088	3.522	5.873
282674.55	98272	11.055	5.873
	196544	5.873	2.827
	21030208.7	5.182	2.103
97304		66	
3168		31092	10.803
778432		21092	1.52
583821		312012	11.053
27304	252		
291912	008		
308259072	260	10.803	5.843
491		10.08	
7994		10.798	5.212

SET PIPE 1.009

N. 0° 27' W. to pipe on E. line of Kelly's and to .001 W. of Nail in stump

N. 0° 02' E. to 1" pipe the N.E. of Kelly's. correction 3 1/2' W. = N. 0° 01 1/2' W. pipe to pipe

(From 1" pipe on E. of Kelly's B.S. of N.E. cor. L. 25 1/2' to spike Δ 5 = N. 0° 27' W.

N. 70° 51 1/2' E. Road

N. 40° 22' E. 408 To car axle N. of road

24.74 3515 S.W. 207 to road makes N 70° 51 1/2' E.

20.05 N. side = 21' = .003 N.

29.43 S. side = 45' = .007 N.

71

11

-1°30' 5.872 1/2" pipe
 -16°25' 911 = 874

set 3/4" pipe in water

12

N. 77° 49' E. 5.099

At S. 6° 07' E. .437 set 3/4" pipe

-11°10' 1.297 = 1.272

set 3/4" pipe

N. 6° 07' W. 6.094

1/2" pipe S. of road .618 across road

+1°50' 4.7015

+15°35' 2.541 to nail
022 N. of
Sum bbl.

At Tp. line set 1 1/2" pipe E. 303

At N. of road set 1/2" pipe N. 78° 48' E. 3075

72

461 N. 1 of
 Kendall Ct. to Hse.
 with road

7.315
 5.870
 13.185
 .149
 13.334

13.185
 .874
 14.059

1.272
 .437
 .835
 1.272
 6.094
 .309
 7.675
 7.456

Total 15.277
 15.131
 .146

4.699
 2.448
 7.147
 .309
 7.456

7.147
 .618
 6.094
 13.859
 1.272
 7.512
 15.131
 .146
 15.277

21618
 .509
 96324
 2.541
 96324
 385296
 481620
 192648
 244759284