

3
4
5
CHAINS

C.S. # 1686

Marysville Block 12


F.B. 87-97

99

1686

Jackson St.

Marysville

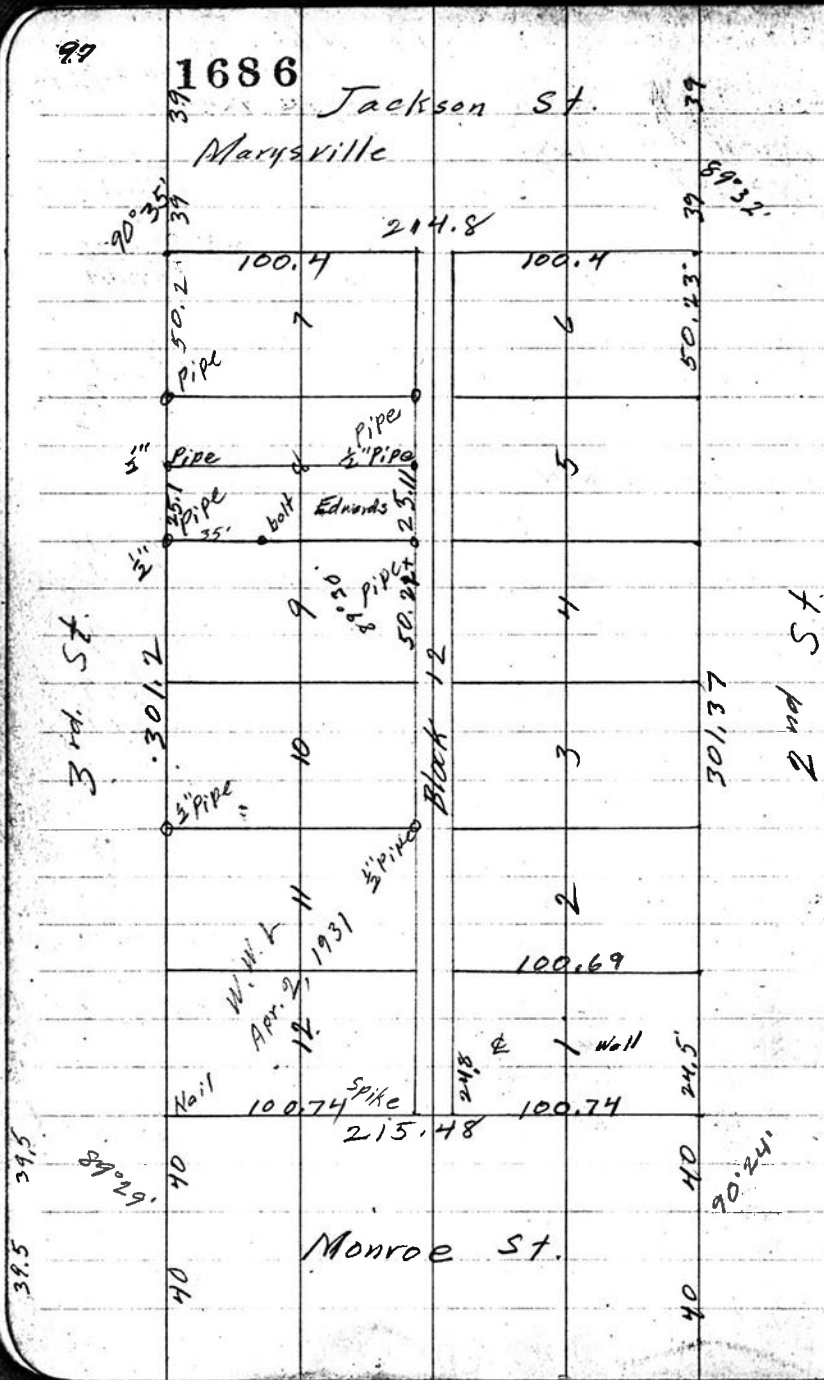

For

98

Laben Edwards and Mary F. Edwards Aug. 16, 1944

3134
11

61301.2
50.2

61301.37
50.23