


C.S. # 1695

Wells and Mc Elroy
Addition
Block 32

F.B. 87-99

FB# 87

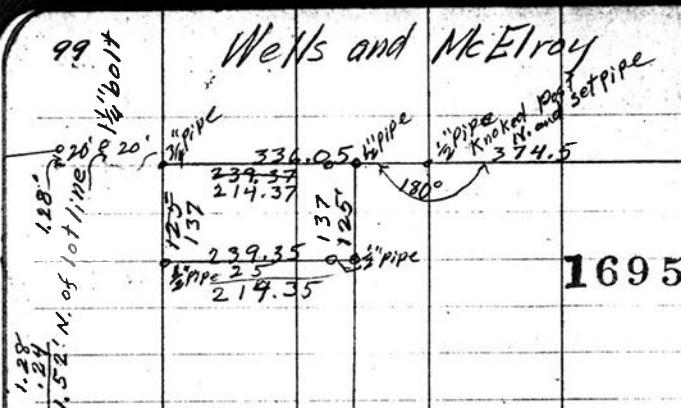

1695

Block 31 32


3671. 5A

E of 357th St

(South Line of Blk. 33 produced W.)

Sept. 27, 1944 100

For C.L. Cor 1

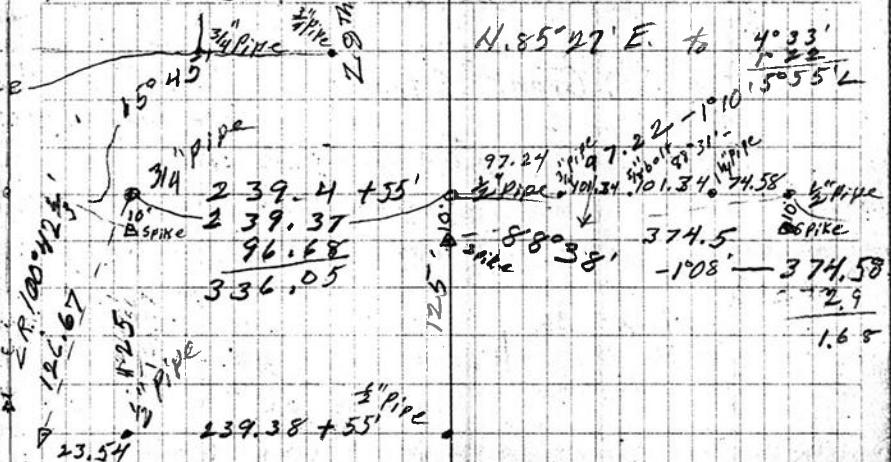

994.67	374.5
97.2	171.82
198.934	21202.68
696.269	101.34
895.203	
96.681924	0
74.58	
97.24	
171.82	