

C.S. # 1724

Hardcopy 11-5 # 1

also see notes in file

F.B. 92-45

11-5

Book 92

ENCLOSURE


FIELD BOOK

No. 4048

48

C. S. # 81
 Price Fuller DLR 37-11-5.
 For Geo Armstrong.

1724

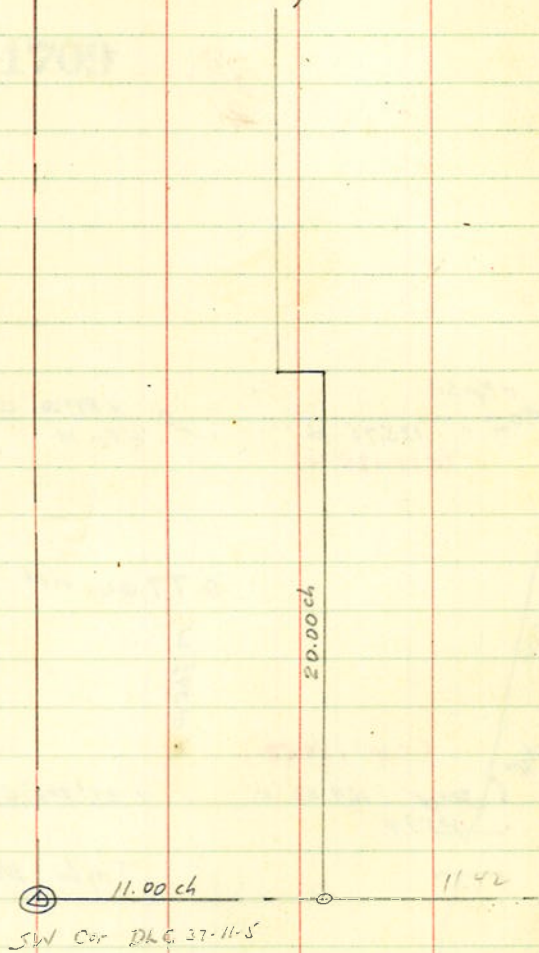

S 36-03 E

8-8-45
 Clara Worn
 Hanson R
 Weir Ch.

49

