

C.S. # 1756

County Addition


Block 25

F.B. 85-12

11

Block 25, Co. Addn & Fract. Blk.  
 C.S. For Jack Porter 1/25/37  
 1310 Harrison St.

10th St.

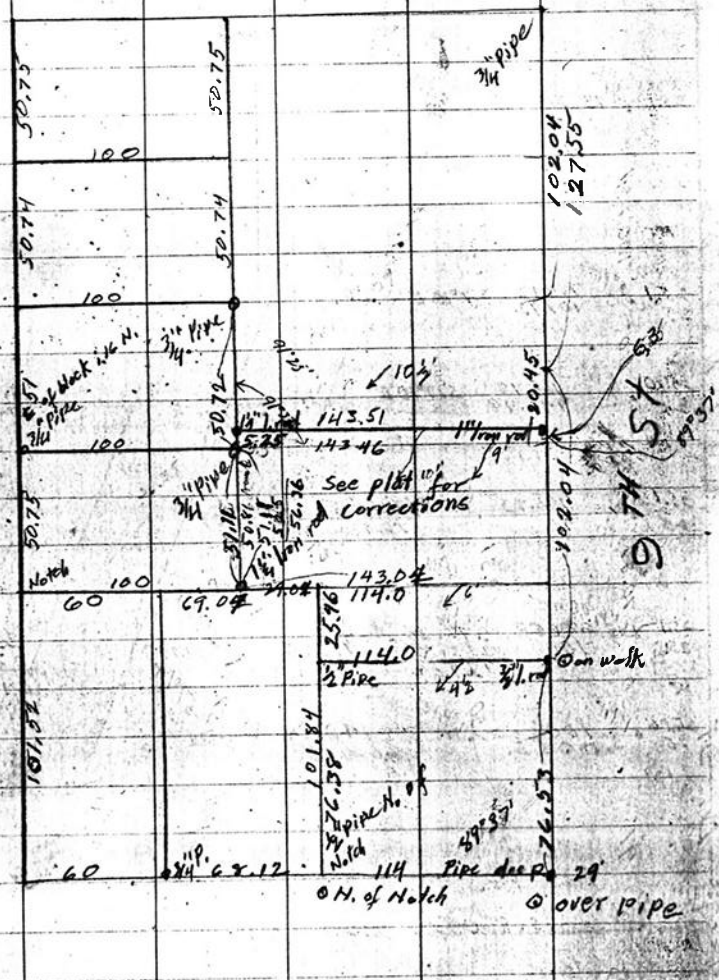

Van Buren St.

For Jack Porter, A.J. Johnson

12

A.K. Wilson  
 Feb. 22, 1946

1756

50.12  
 152.27  
 101.52  
 50.95  
 152.27

40220  
 243  
 729  
 7210  
 7482  
 1240  
 1215

555  
 22  
 4.96  
 20.45  
 25.81

25.78  
 20.58  
 5.78  
 6.2  
 5.16

25.45  
 25.87  
 25.87 from transit line to N. line of Porter's

62 s. of pipe for line II to N. line of Van Buren  
 42 should be 42 N. for E of block  
 20 Pipe should be 20 S. for lot line 35' S.

51.84 permit to 3/4\"/>

51.34  
 35  
 50.99