

C.S. # 1765


Wells and McElroy

Block II

F.B. 87-111

111

Taylor

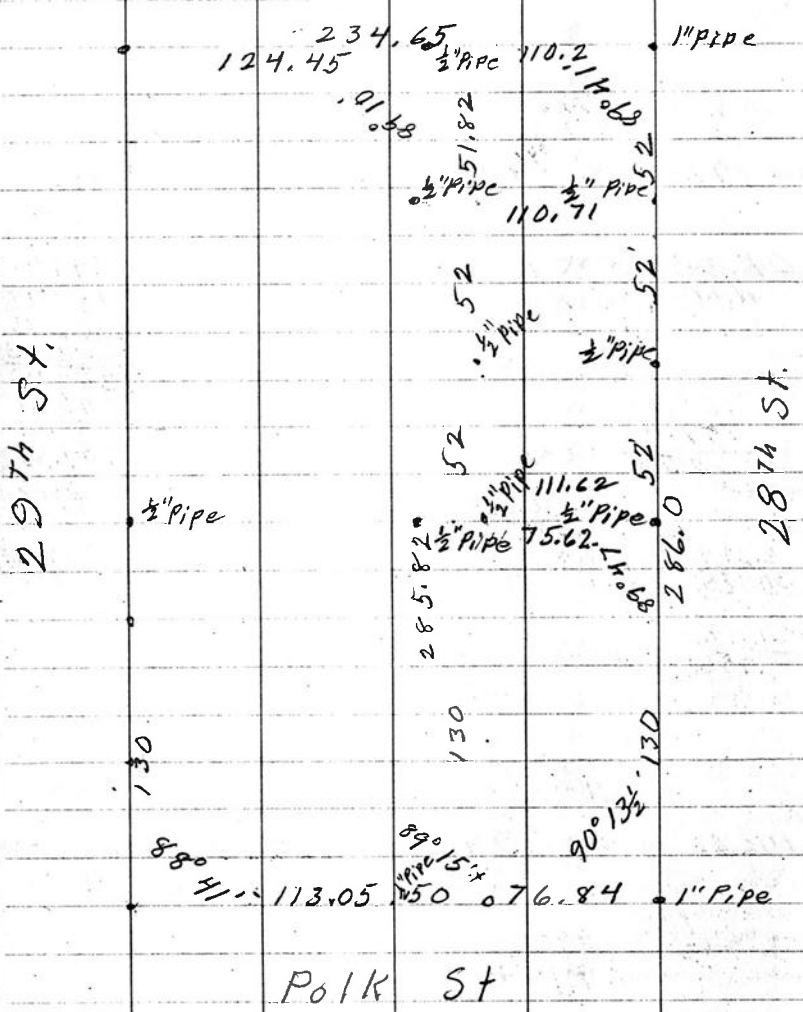

John L. Dugall
For Modern Builder

1765

112

March 30, 1946.

286.00
130.00
3 | 156.00
52.00

286
52
234
52
182
52
130

234.65
124.45
110.20

285.82
130
3 | 155.82
5

127.00

36.08
76.84
112.84
110.2

32
00923
286 | 2640
2574
660
980