

6
12
CHAINS


C.S. 206 Continued

OTTO H. MEYER
CIVIL ENGINEER
621 North 35th Street
CORVALLIS, OREGON

1887

May 17, 1946

3/4" pipe, 37.98 ch. East & 9.60 ch. South
of N.W. corner David B. Butterfield D.L.C. #47-12-5

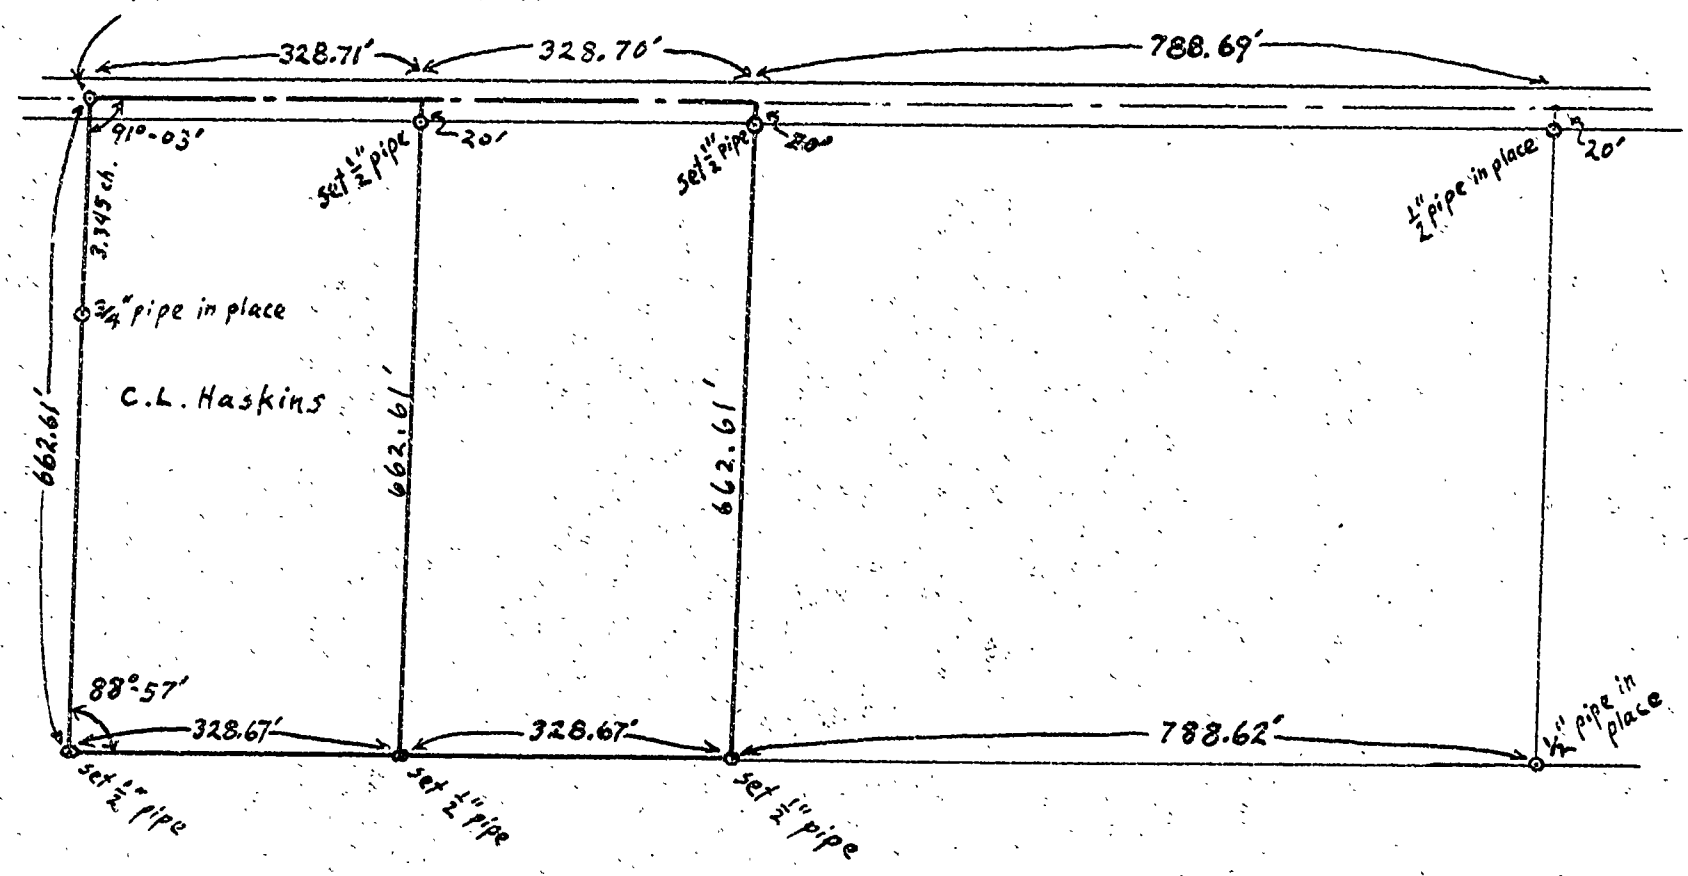

Survey of part of Pernot Tracts in David B. Butterfield
D.L.C. #47, run May 15, 1946.

