


11-6
3283

Township 11 South, Range 6 West W.M.

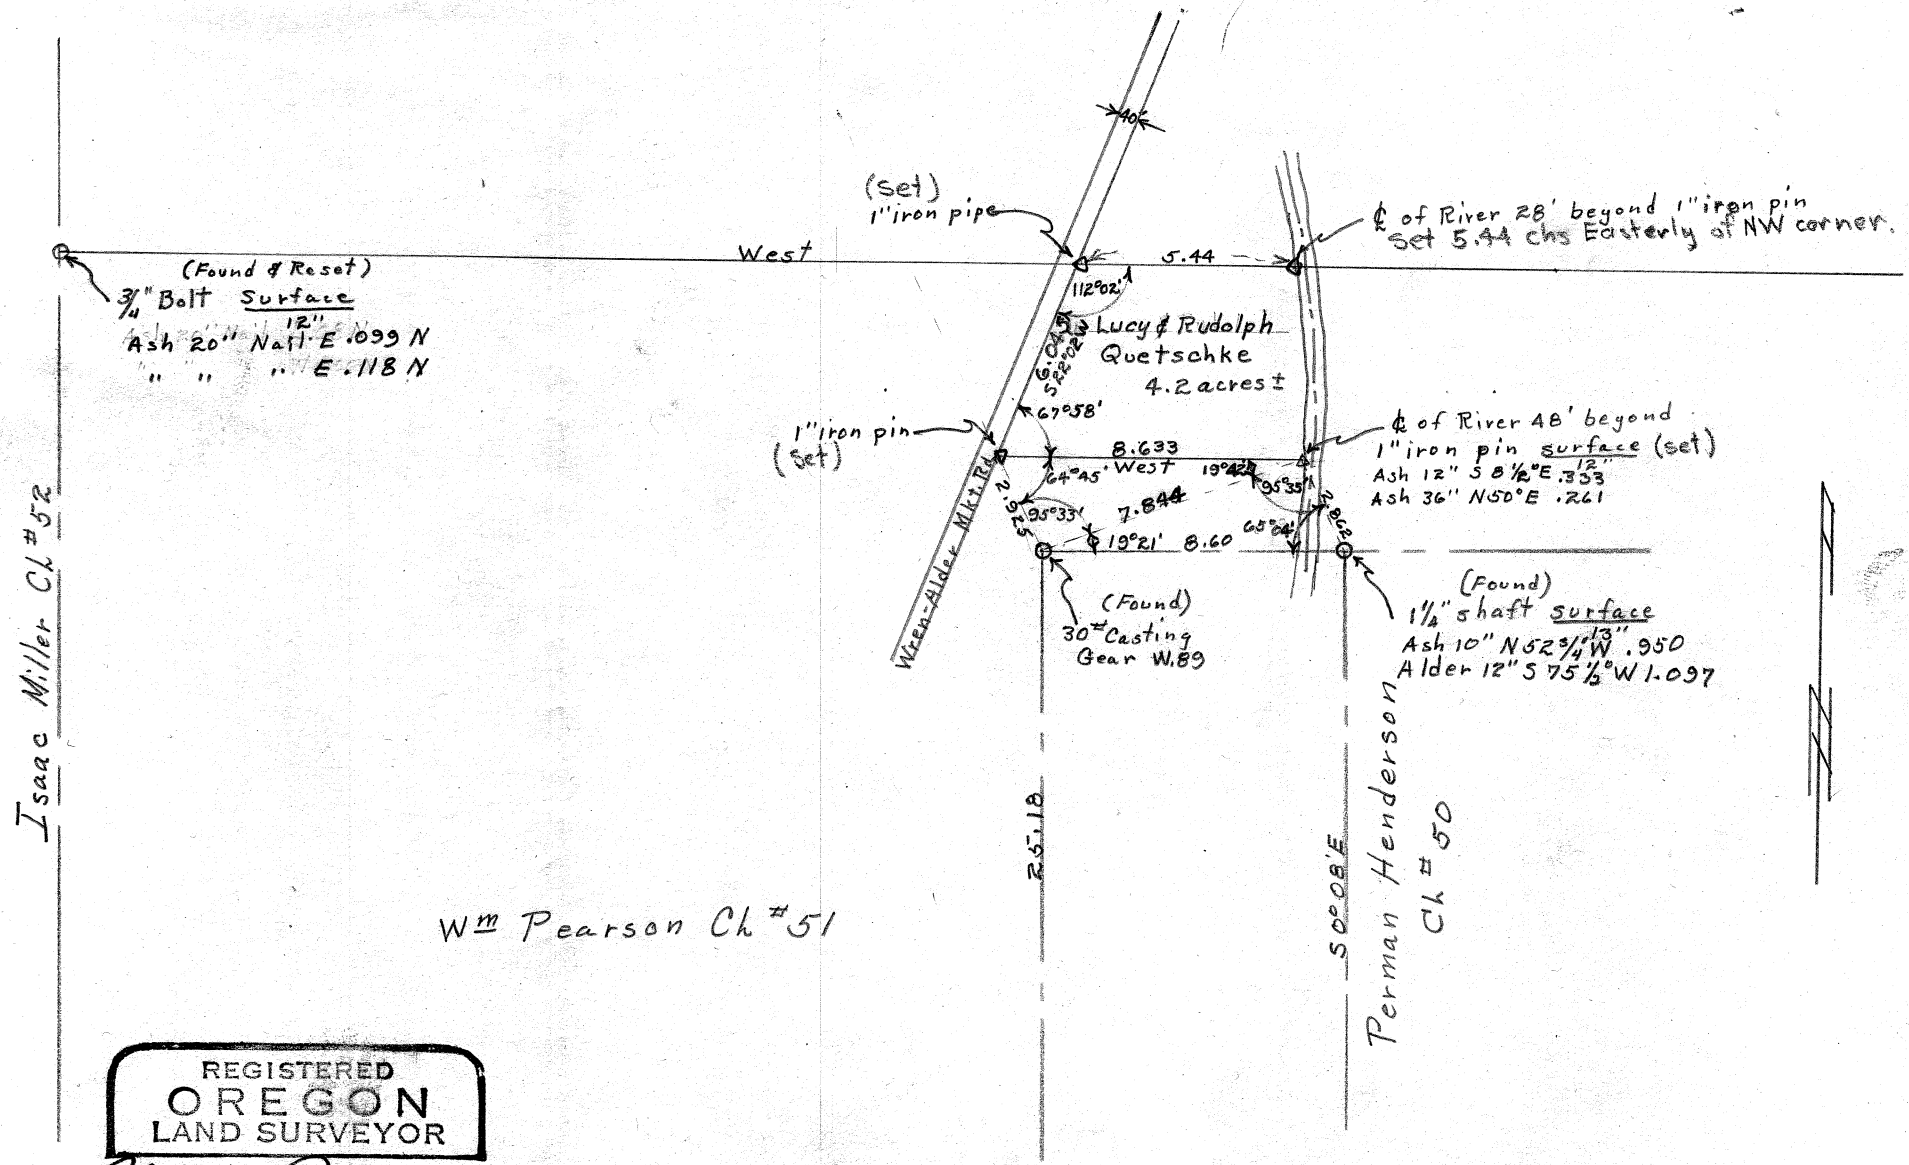

Isaac Miller Ch # 52

Wm Pearson Ch # 51

Perman Henderson
Ch # 50

REGISTERED
OREGON
LAND SURVEYOR

Martin P. Coopey

MARCH 9, 1945
MARTIN P. COOPEY
155

1803

Entered on plat 11-6 sec 32+33
23 Aug 1946
h.28
C.S. 296

H. Board