


CS 279

PLATTED

OTTO H. MEYER
CIVIL ENGINEER
621 North 35th Street
CORVALLIS, OREGON

Dec. 23, 1946

1835

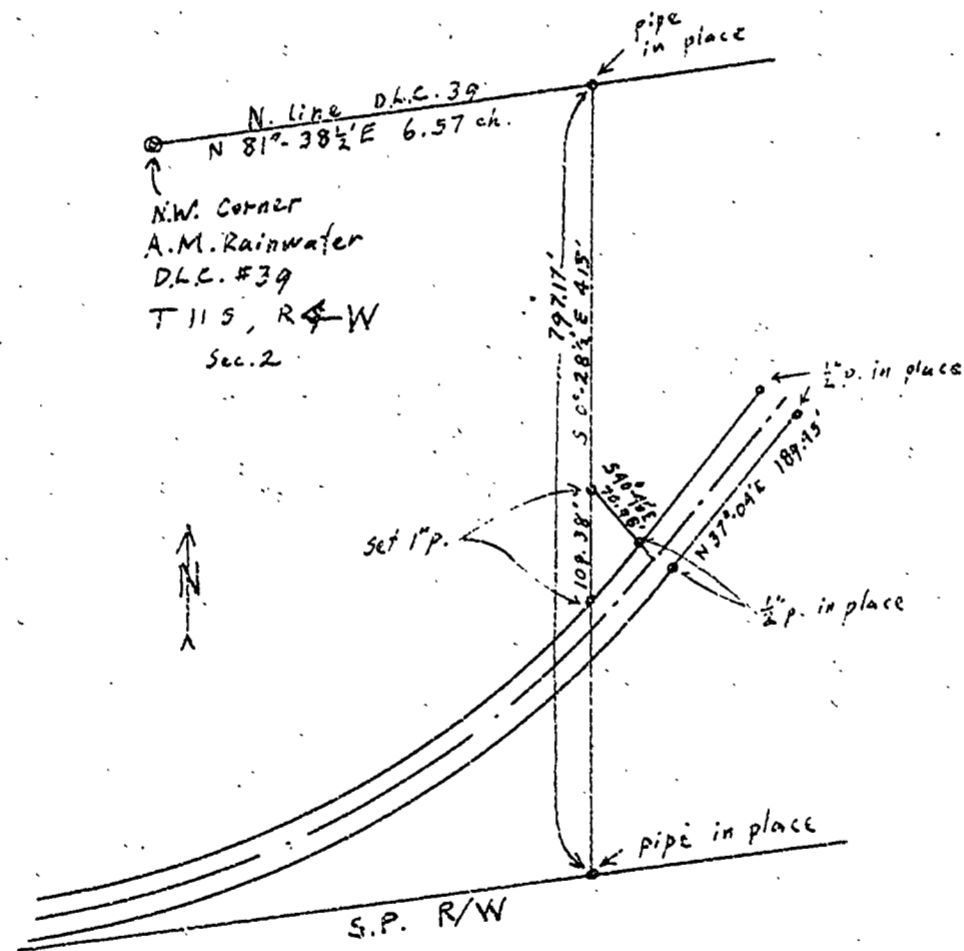

1" = 200'



Platted M.L.B.