

C.S. # 1838

Sunset Park

Block 4

F.B.

17

LINE DATE _____ PARTY _____

PROJECT _____

KILHAM FORM P-172

1:3071

S.E.W. S41
DLC

College St
6.00
Int. of Col. & Cl. Line
90°

Main

88°18'

382.55

South St. Prod. E.

88°15'

Set 3/4" Pipe on South St.

Set 3/4" Pipe 1.15' S & 0.20' E of Int.

200.73

89°

6.00

3/4" Pipe in Qt Bottle
surf (FL)
12"

Philomath

↳ 30" short.

17

Block 2 - Sunset Park

College St

204.92

Set 3/4" Pipe

Set 3/4" Pipe

81.00

Set 3/4" Pipe

91°47'

91-46'

153.08

30

30

76.79

Set 3/4" Pipe

387.20
"N" St.

4

3

Set 3/4" Pipe

cl. 60.45

d = 0.35'

cl. = 232.19

d = 20.34'

Set 3/4" Pipe

AP 89°56'

90°00'

Set 3/4" Pipe

88°18'

Main St. (Highway) 216.00

40.02

CITY LIMITS

18

LINE DATE

PARTY

PROJECT


KILHAM FORM P-172

1-3071

Philomath Is ✓

(18)

Block 3 - Sunset Park.

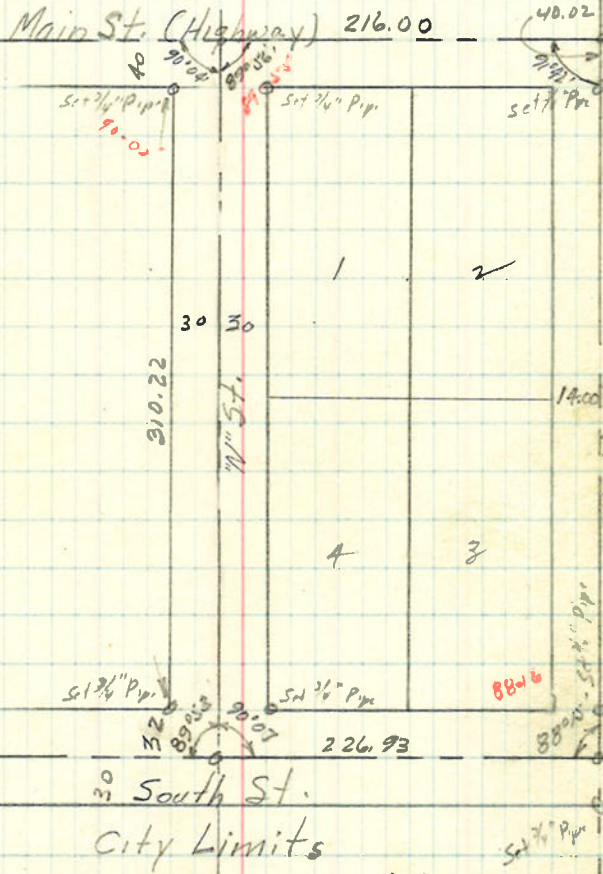

19

LINE DATE

PARTY

PROJECT

KILHAM FORM P-172

119071

Philomath

L 5' 30" short

19

Block 4 - Sunset Park

