

C.S. # 1841

Wells and McElroy

Blocks 29-31


F.B. 107-12









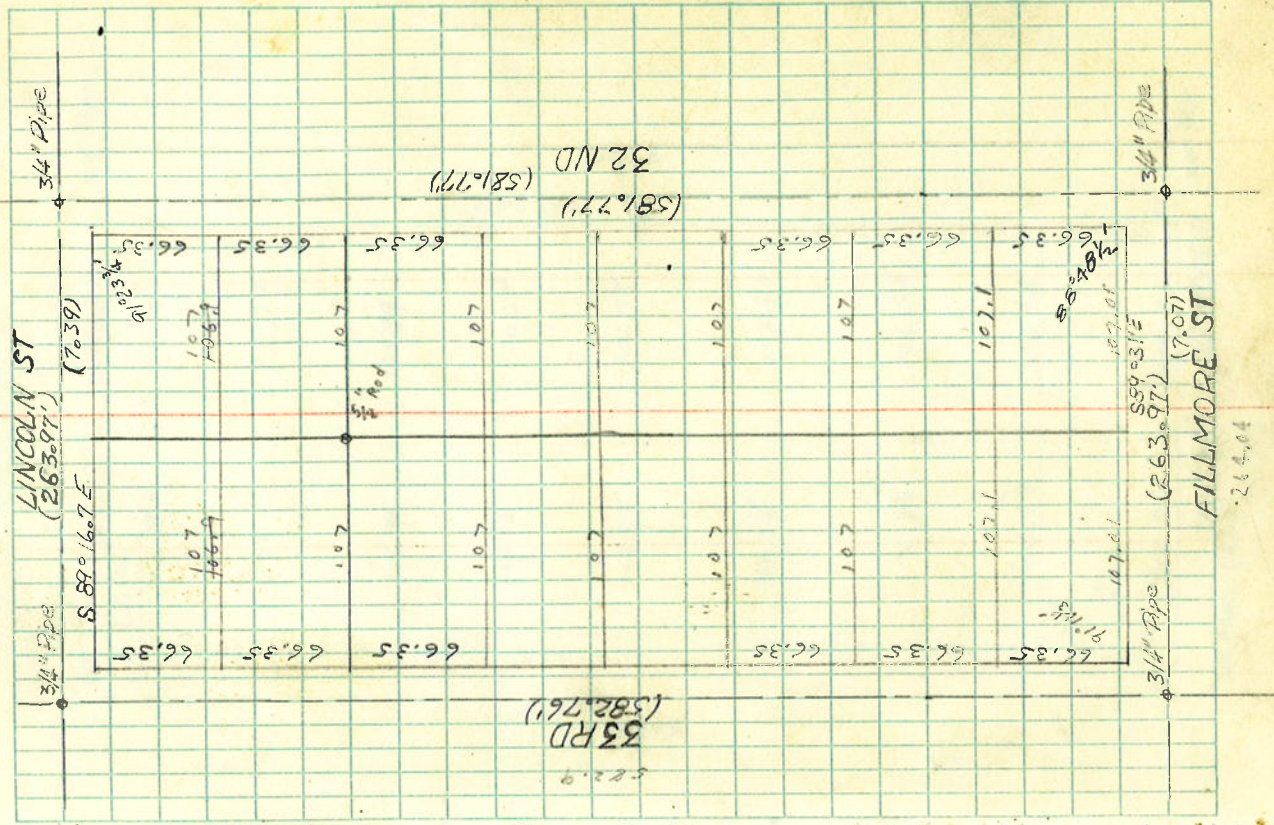

FILLMORE ST



