

C.S. # 1844



Philomath Farm Lots

Lot 1

F.B.

Form Lot 1 Add.
to
Philomath

South St

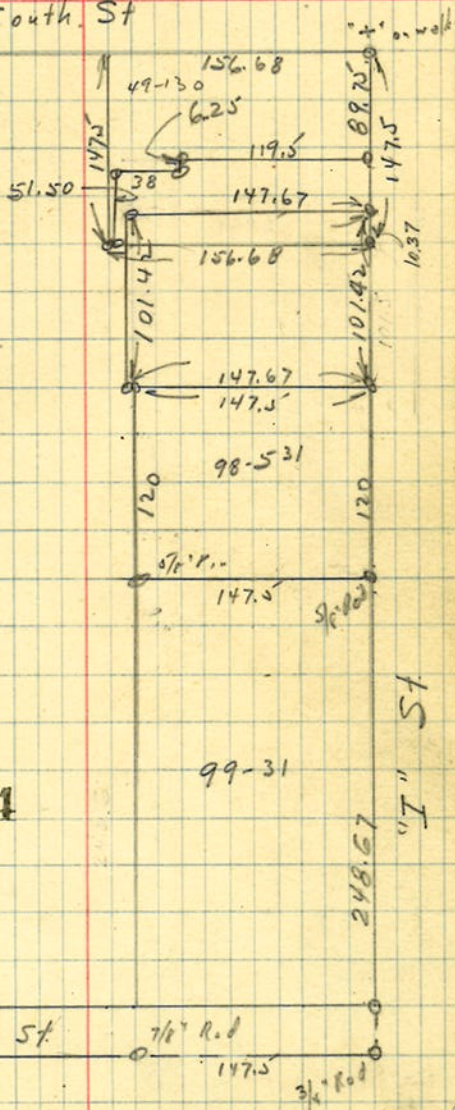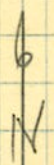

1844

99-31

11" St

Vacated St

7/8" Rod

3/4" Rod

30

7/8" Rod

147.5

3/4" Rod

248.67

5/8" Rod

5/8" Rod

120

130

147.67

147.5

51.50

147.2

49-130

156.68

625

119.5

147.67

156.68

101.42

10.37

147.67

147.5

98-531

120

130

5/8" Rod

147.5

5/8" Rod

99-31

1844

7/8" Rod

147.5

3/4" Rod

248.67

11" St

99-31

1844

7/8" Rod

147.5

3/4" Rod

10.37

89.75

147.5

147.5

10.37

10.37

