


C.S. # 1862

See notes in file

F.B.

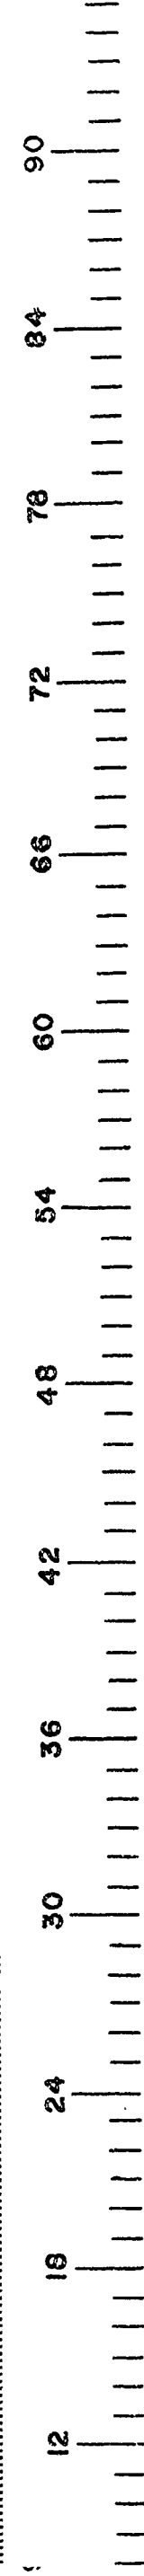

17-8 LINE DATE 1-27-47


Hanson  
PARTY Bexton  
Wells

H. F. Covey

JECT

7	Granite Stone (Independence School cor.)	3.597	3.597
6	-	7.715	7.715
5	-	-2.00'	7.822 7.715
4	-	-4.42'	7.700 7.674
3	LRT 0.002' (top of hill)	+3.34'	4.860 4.951
2	-	+1.20'	6.470 6.468
1	to 3/4" Pipe (S.W. Cor. Chisham Cl # 54)		

1862

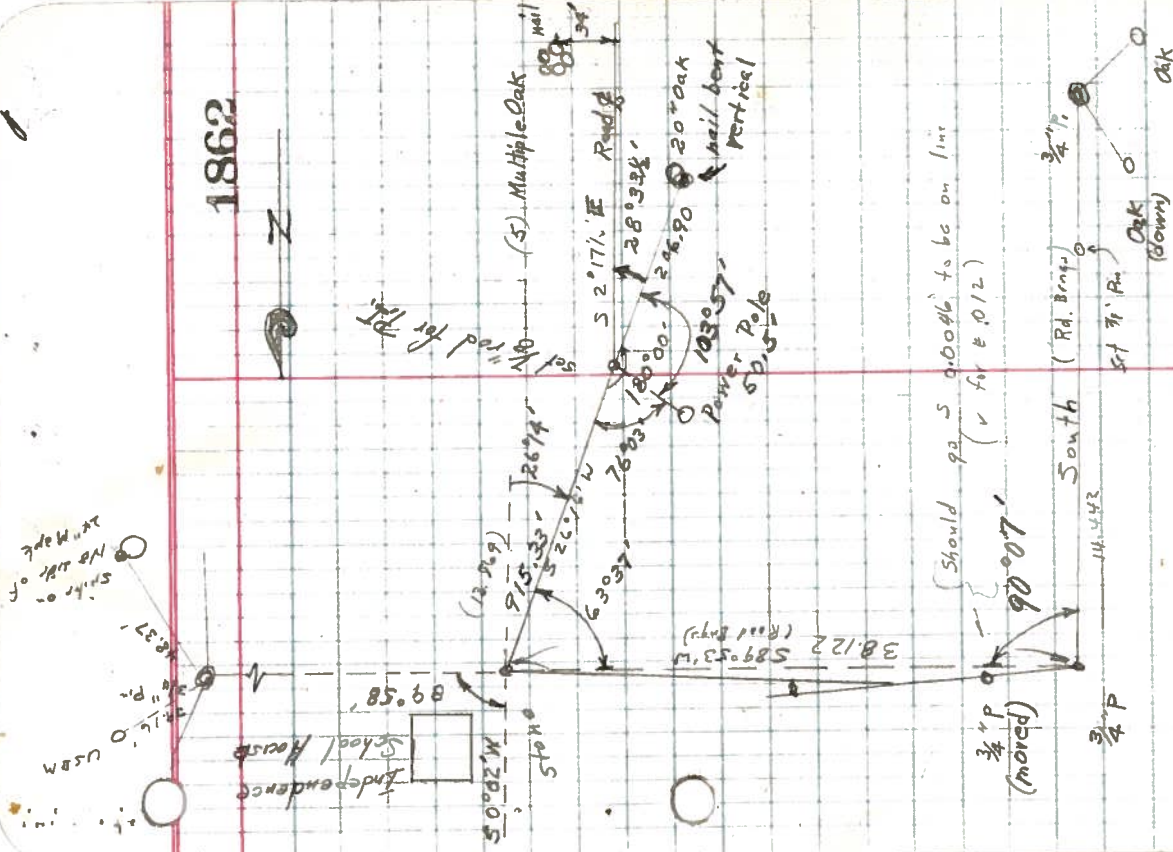

47-8  
41-12-6

1862

