

C.S. # 1886

Johnson's Addition


Block 14

F.B.

47-29
 Johnsons Addn
 Block 14

1886 4-5-47

For Earl L. Chapman

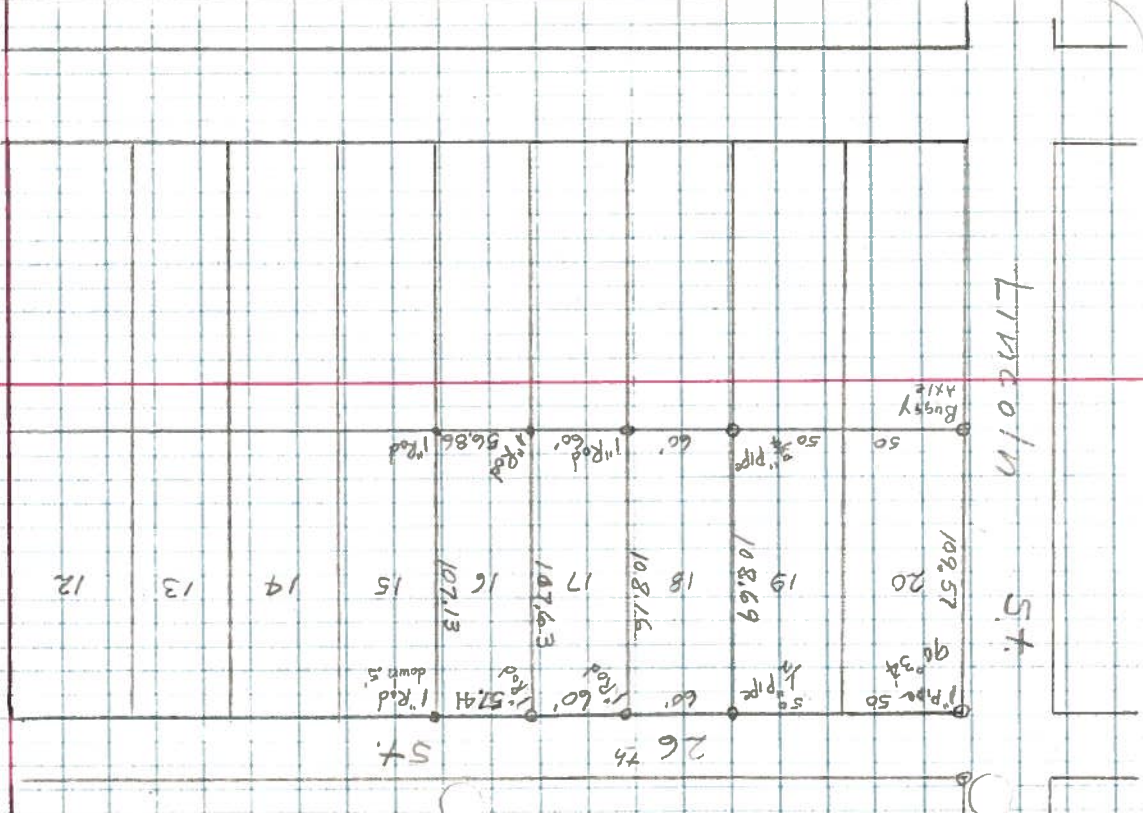

ST. 4107117

LINE DATE April 5, 1947 PARTY BHG

PROJECT

SI-MEM FORM 7-77

128071