


102  
96  
90  
1" = 6 CHAINS

OTTO H. MEYER  
CIVIL ENGINEER  
821 North 35th Street  
CORVALLIS, OREGON

June 20, 1947

1911

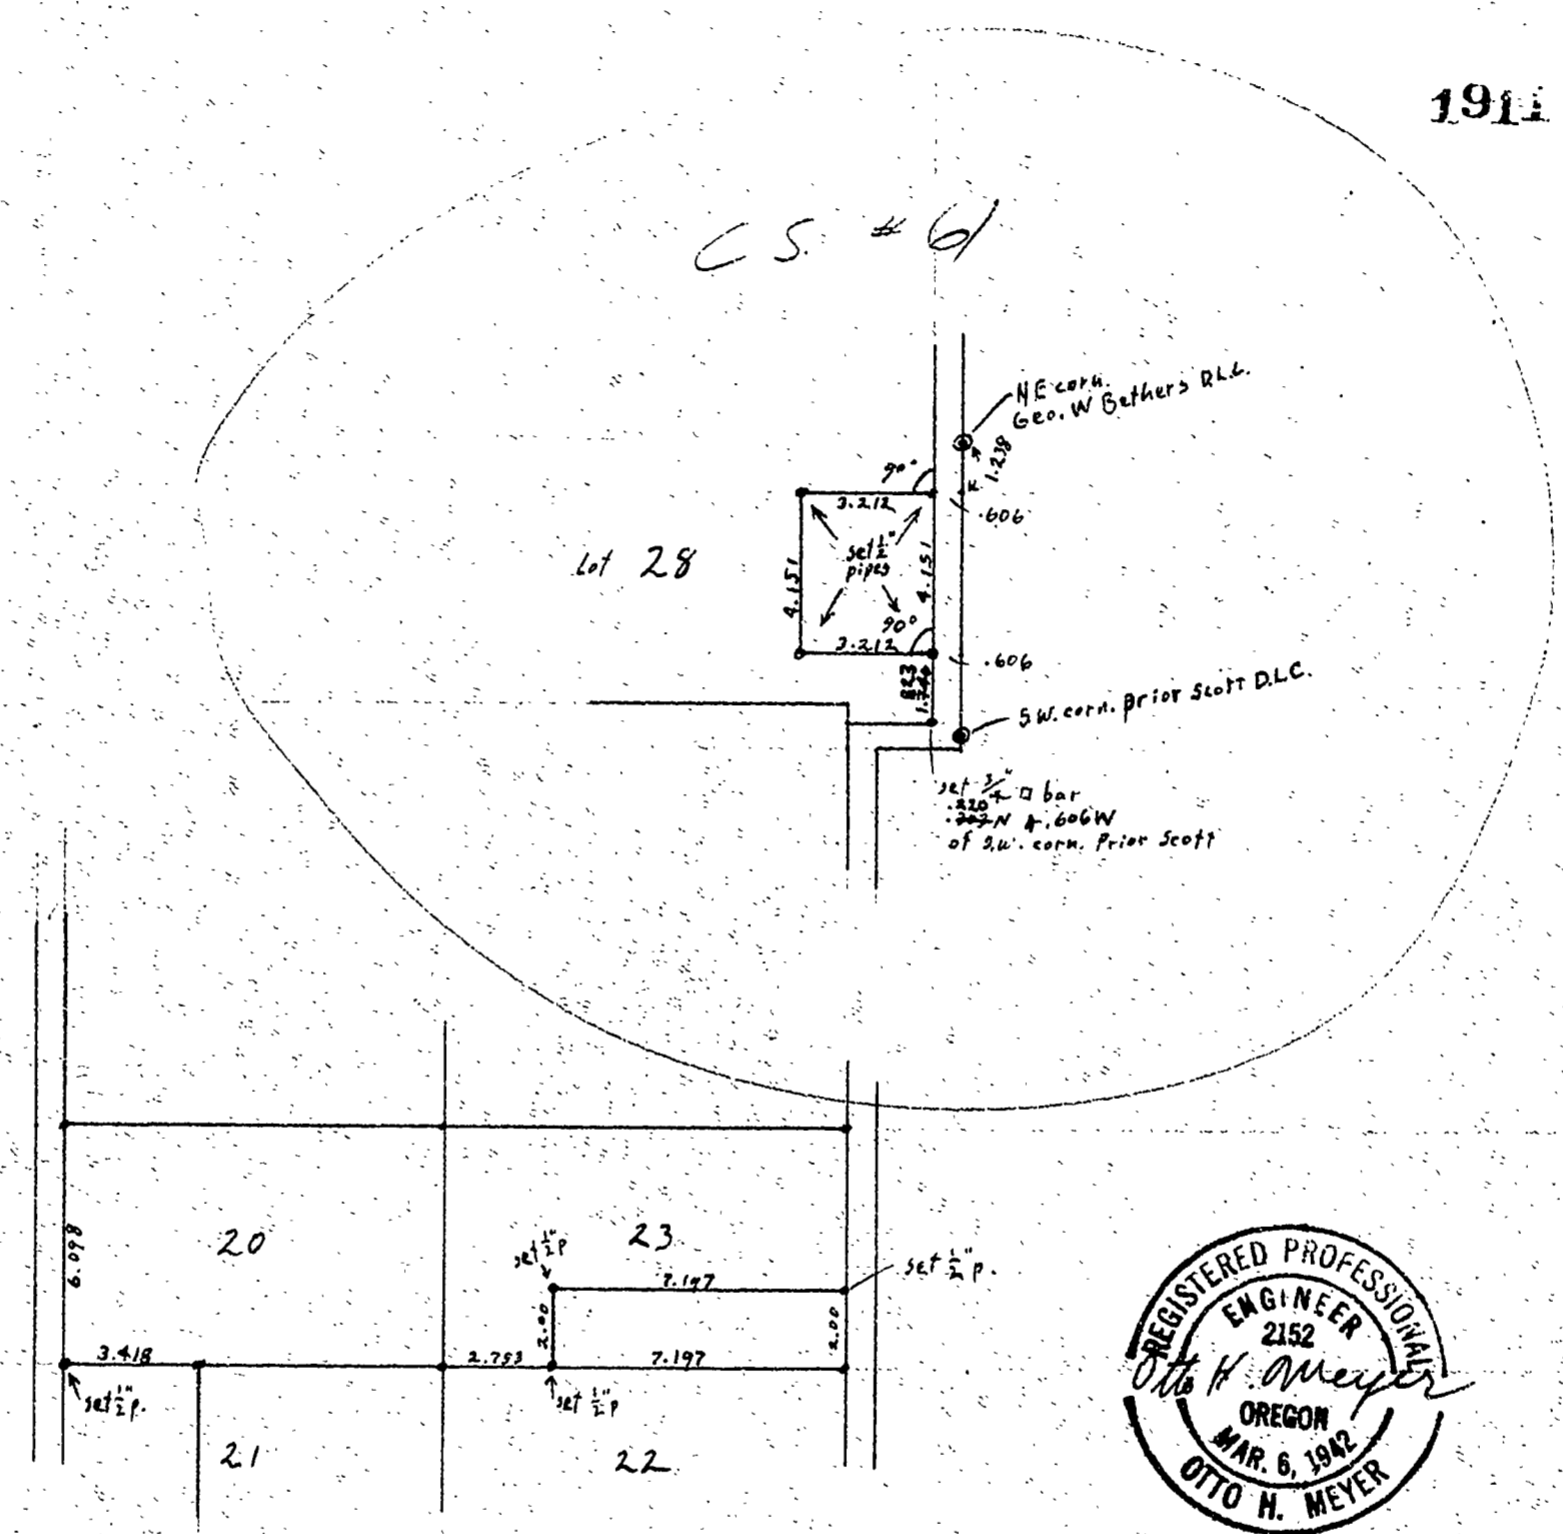

File PLEASANT VIEW FRUIT FARMS  
Nov 11, 1947 12-5-9  
CK. C.S. # 264

RFFI 12 FRAME 85