


OTTO H. MEYER
 CIVIL ENGINEER
 621 North 35th Street
 CORVALLIS, OREGON

Not in 1920

July 21, 1947

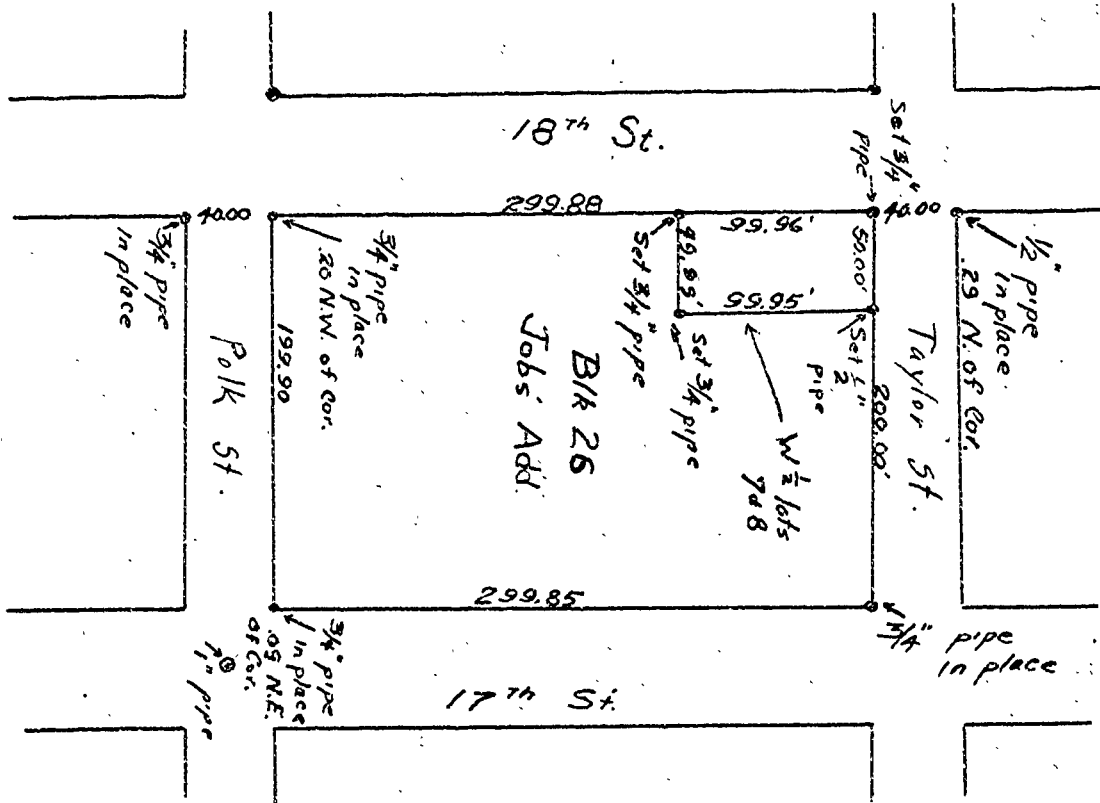

1" = 100'

