


C.S. 79

10-4  
Sec. 27

OTTO H. MEYER  
CIVIL ENGINEER  
621 North 35th Street  
CORVALLIS, OREGON

Oct. 2, 1947

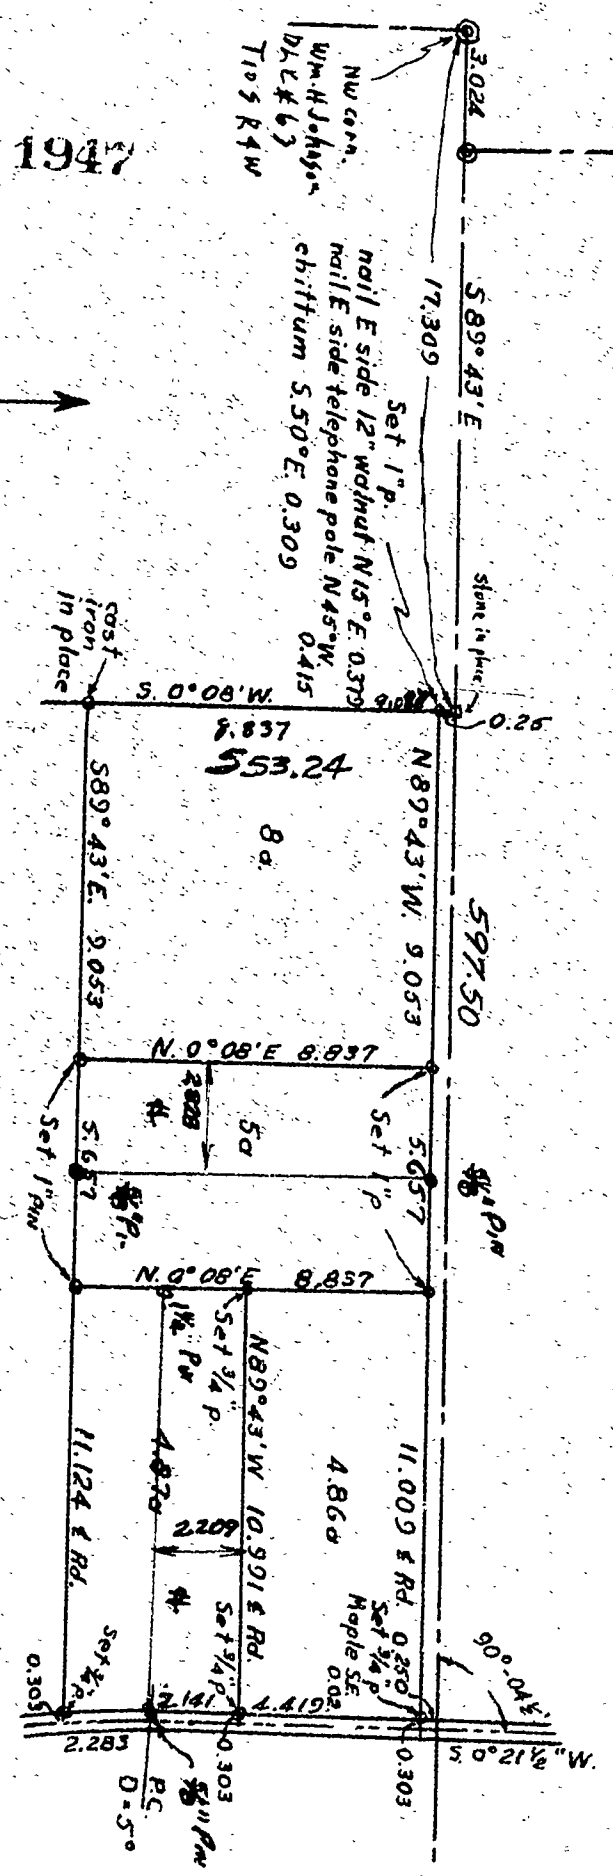

Scale: 1" = 5 CH.

