

C.S. # 1971

Hardcopy 14-5 # 7

also see notes in file

F. B.

CI 44-14.5
C.S #174

For Benton Co. Flax Coop

12-1-47

1971


LINE DATE _____ PARTY _____

PROJECT _____

MINN-DORN P-372

Δ_{3A}		-	54.05	(54.05)
Δ_3 Δ & RR	7° L/LT	$89^{\circ} 51'$		
Δ_3	1° L/RT	$90^{\circ} 09'$		
Δ_2	1° L/LT	$75^{\circ} 13'$		
Δ_2	1° L/LT	$67^{\circ} 34'$		
Δ_1	4° L/RT	$89^{\circ} 51'$	E to S	

RR spikes set by direct ranging in between extrem 1/4" pipes
 E. Claim line
 W. Claim line

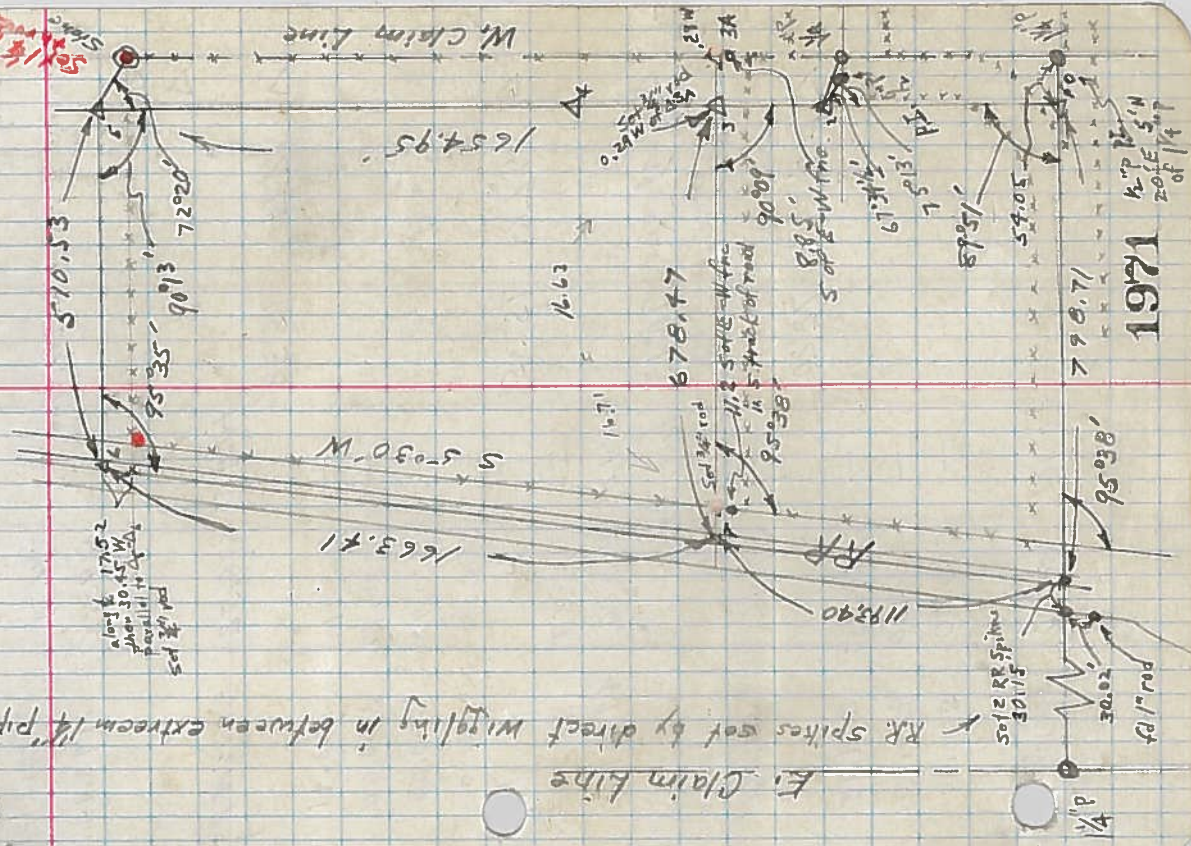

1971

12th P 5th N
 20th E 5th P
 20th of 14

Set 1/4" P 10m
 1/4" P 10m

