


OTTO H. MEYER  
CIVIL ENGINEER  
621 North 35th Street  
CORVALLIS, OREGON

Dec. 4, 1947

1974

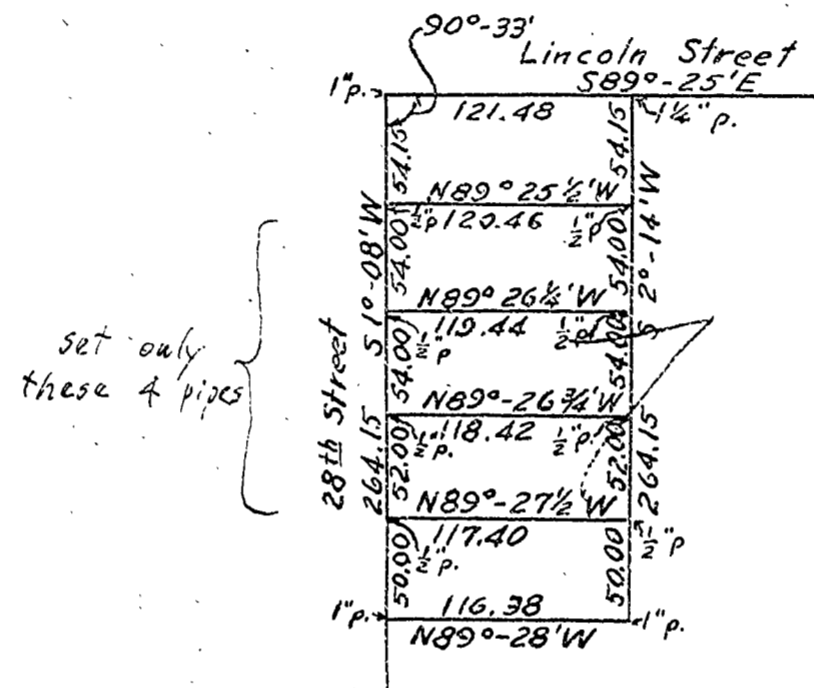

Scale: 1" = 100'

