


Plat of Survey No. **102 #198** Claim No. **53**

MADE FOR **R.E.L. Brown**

Section..... Township **10 S.** Range **6 W.**

Scale: **5** Chains to the Inch.

Field Notes recorded at page **30**, Vol. **8**, Record of Surveys.

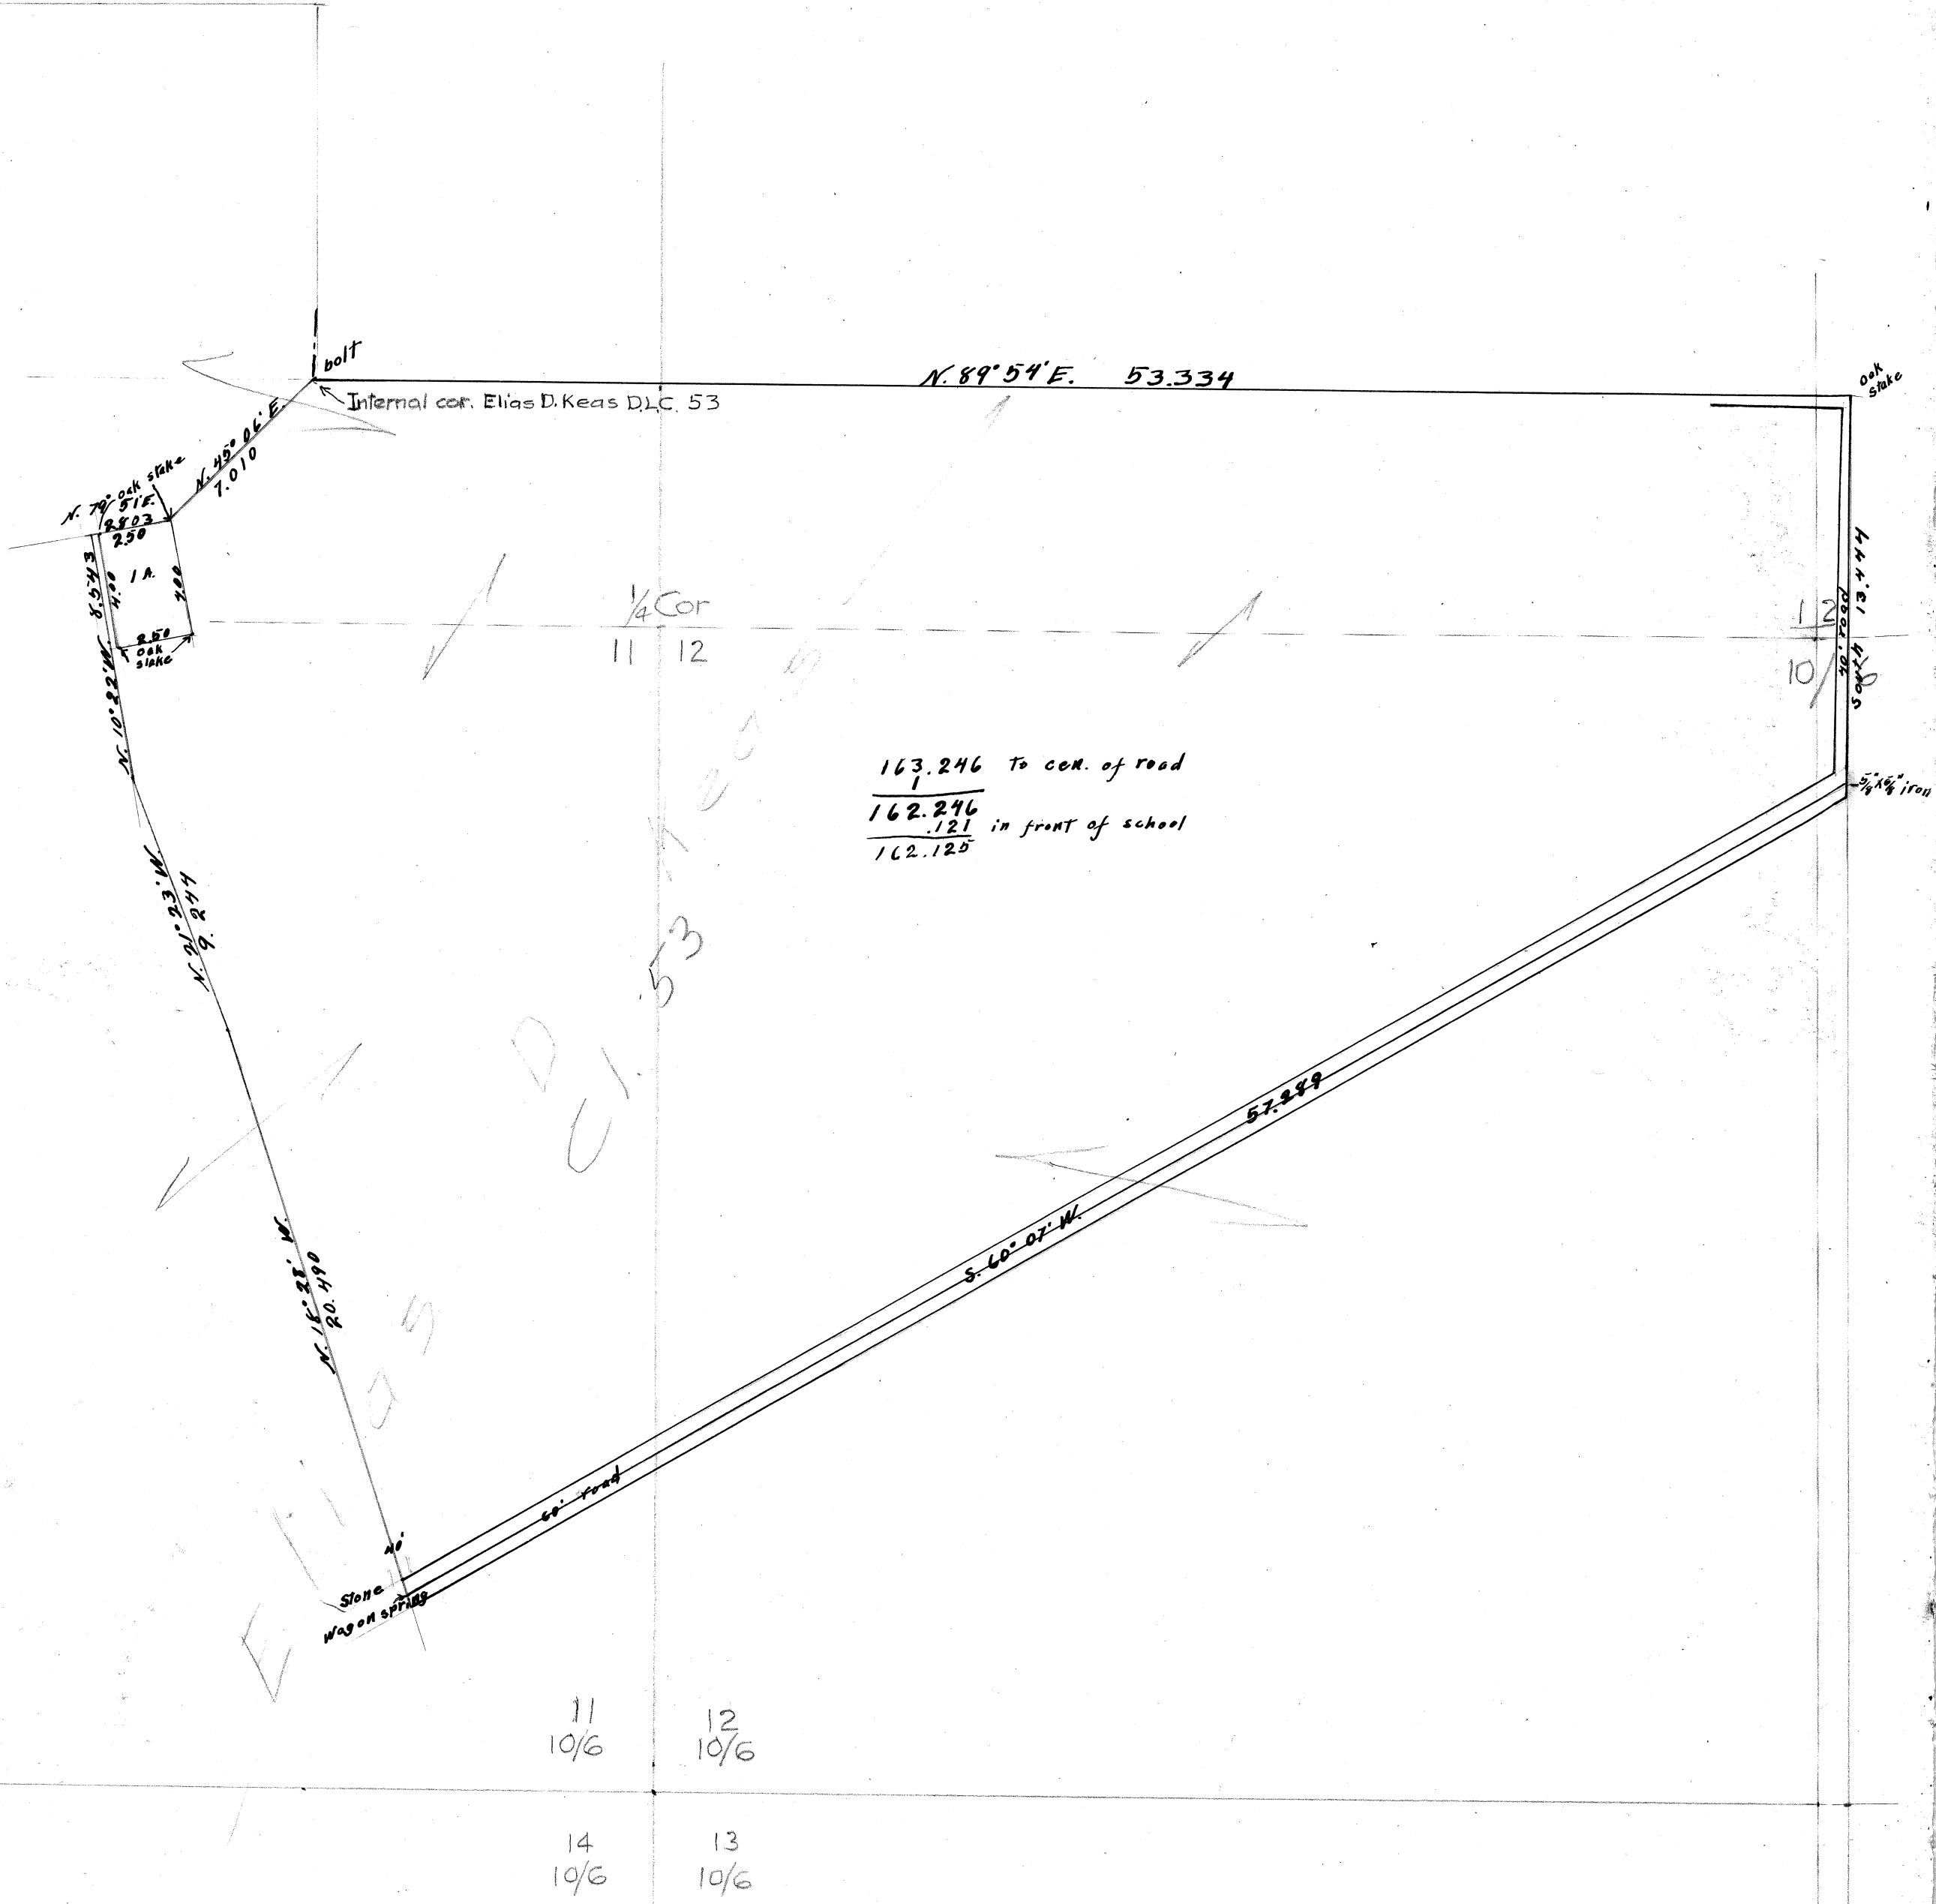

81

S. 60° W.
8.57.54 W.

10 2,375 = 2007
10 30' 8,000
11 10 30' 8,000
16,000
10 30' 8,000
14,930 = 57,289

Set wagon seat Spring

8.57.26 N. 30° 45' E. 14.97 obs. MKd. R.
Double 24" N. 69° 13' W. 785 " " R.

N. 18° 36' W.

8,000
8,000
4,510 = 20,440
8,000 = 9,244

1,245 ^{8.57.3}
8,043 ^{303 Mt. Oak State}
2,818 ^{To N.E. School H. 17}

Offset N.W. of cor.

15 1,006
16 N. 44° 33' E. 4° 10'
17 correction S. 20° 50' 15"
To O L. Right 5° 33' 15° offset = 107
1,151 = 2,010

2,375
18
19,000
1662
20,205 = 2

4,510
63,799
40,590
40,599
315
13
12
44,979

2,818
5,249
2,532
2,536
112
14
2,8024
4,722
63,799
42,498
42,498
330
141
12
4,7093
1102
1769
9,918
665
71
10,657

107
1,052
1,00727 = 25'
4,907
1,930
1,402
5,280

2,375
.007
2,368
7,997
7,997
16,000
7,997
14,930
57,289

8,000
7,992
4,498
20,490

7,997
1,240
9,244

8,093

2,803
1,203
2,500

4,709
1,304
1,099
7,010