


OTTO H. MEYER  
 CIVIL ENGINEER  
 621 North 35th Street  
 CORVALLIS, OREGON

Feb. 24, 1948

199'

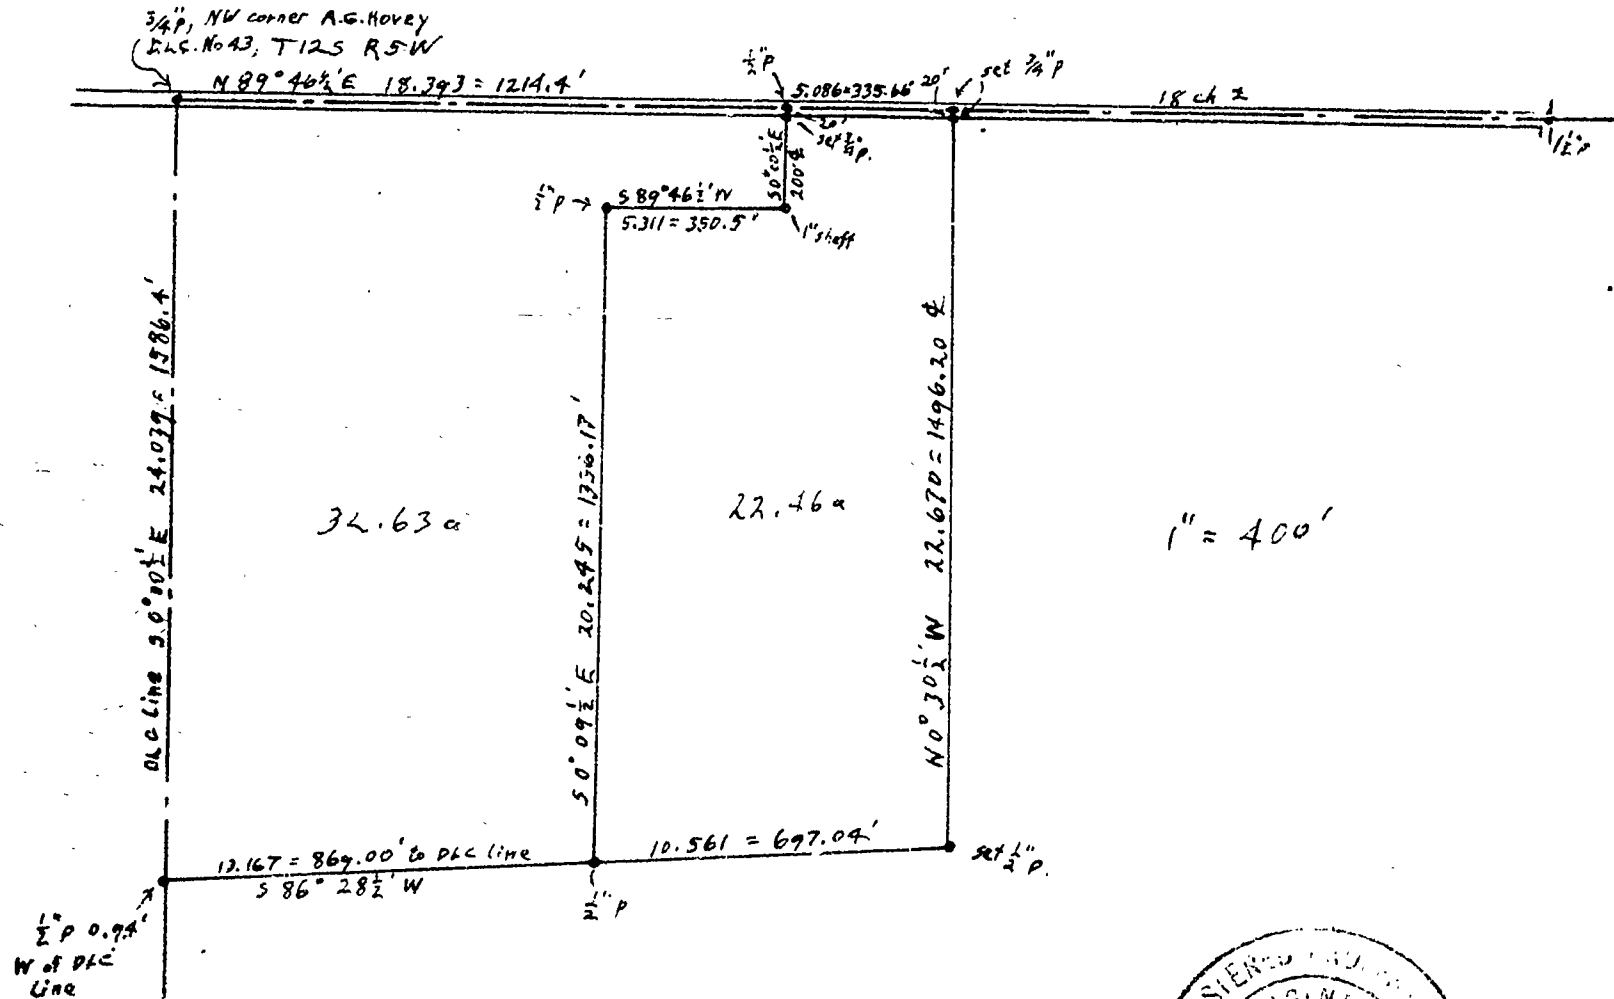

T12S R5W SEC. 5  
 Corvallis, Oregon 12/2/48

