

post marked corner Sec. 32 & 33,
T10 S R9 W, set by R.G. Whitten
3/25/43 (dubious)

set 3/4" p for
NW cor. Sec. 4, T11S R5W
orig oak 552°E 4.40 ch
10" oak N87°50'W 97.0'

set 1/2" p
X on 6' boulder
S83°40'E 25.5

set 1/2" p for 1/4 cor.
N line Sec. 9, T11S R5W
orig oak S44°E 2.25 ch. (matched in 1912)
24" " S67°20'E 30.9' (" N side in 1912)
12" " S85°W 7.7'

1" = 400'

88.23 a.

2005
Gateway No. 287


OTTO H. MEYER
CIVIL ENGINEER
621 North 35th Street
CORVALLIS, OREGON

Mar. 22, 1948

shaft in place
1/4 cor. Sec. 4-5
T11S R5W

set 1/2" p.

pipe in place
E Ute Rd.

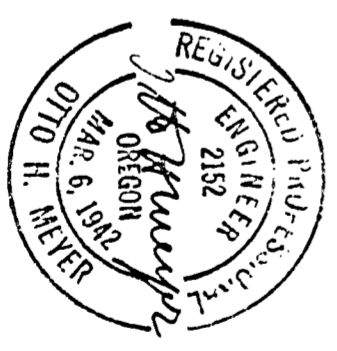

OTTO H. MEYER
 CIVIL ENGINEER
 621 North 35th Street
 CORVALLIS, OREGON

Mar. 22, 1948

2005
 Galloway N² 287

