


OTTO H. MEYER
CIVIL ENGINEER
621 North 35th Street
CORVALLIS, OREGON

May 12, 1948

2020

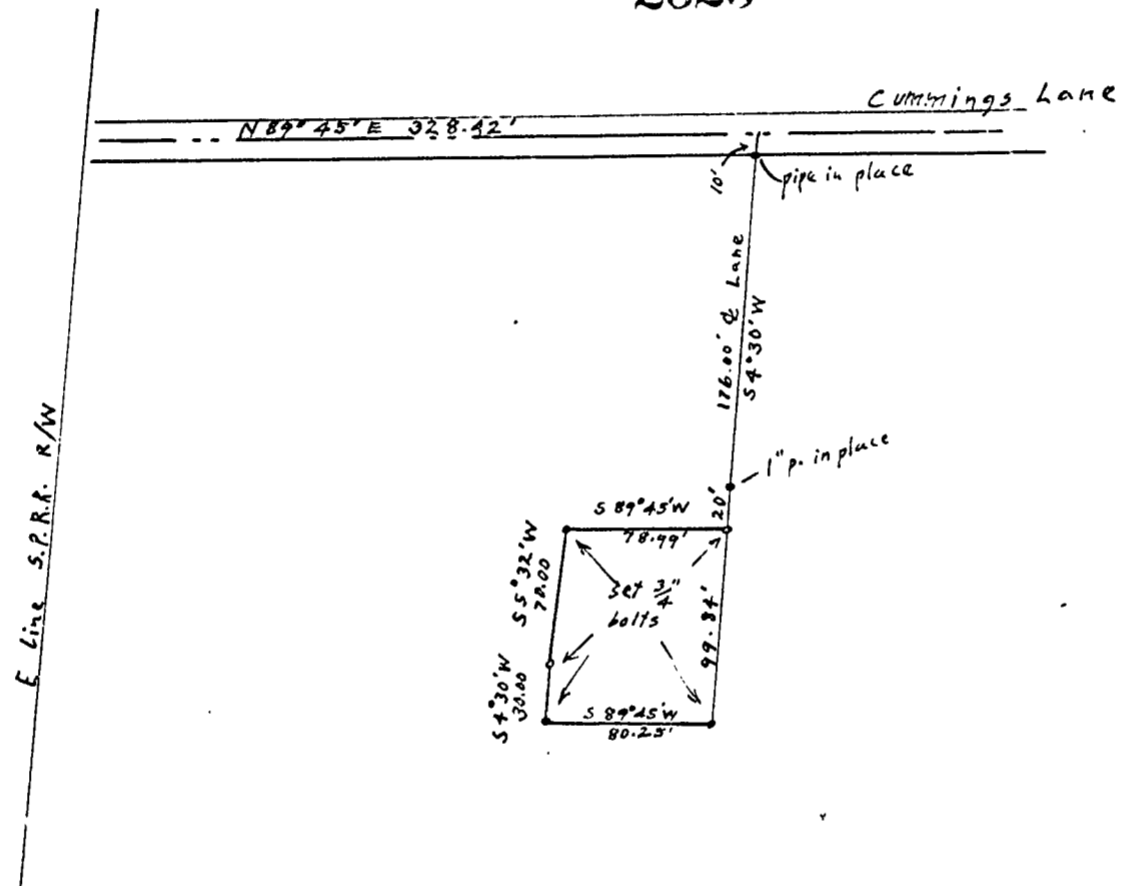

1" = 100'

In Joseph C. Alexander
D.L.C. No. 16, T12S, R5W, W.M.
Gateway No. 16

