

C.S. # 2025

Hardcopy 11-5#20


also see notes in file

F.B. 111-7

C. S. 4129, Dixon Co. Division

2025

June 17, 1948 by W.C.G. & Sid. W. Lossdorfer
for Robert Witzig

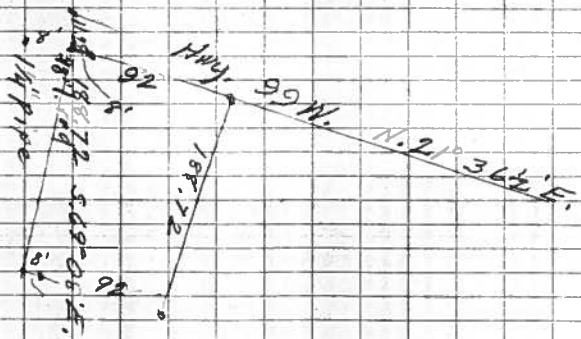

200.00
 11.28
 188.72



End of Book