


C.S. 272

Platted D.W.S. 9-4-27

OTTO H. MEYER  
CIVIL ENGINEER  
621 North 35th Street  
CORVALLIS, OREGON

Aug. 22, 1948

2043

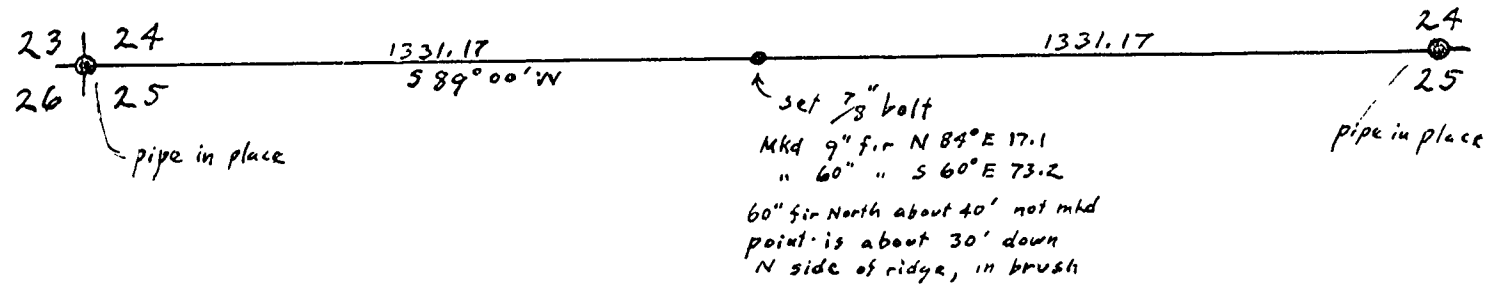

S. line sec. 24, T 10 S, R 7 W

1" = 400'

