


OTTO H. MEYER
 CIVIL ENGINEER
 621 North 35th Street
 CORVALLIS, OREGON

2046
 Galloway No. 124.

Sept. 26, 1948

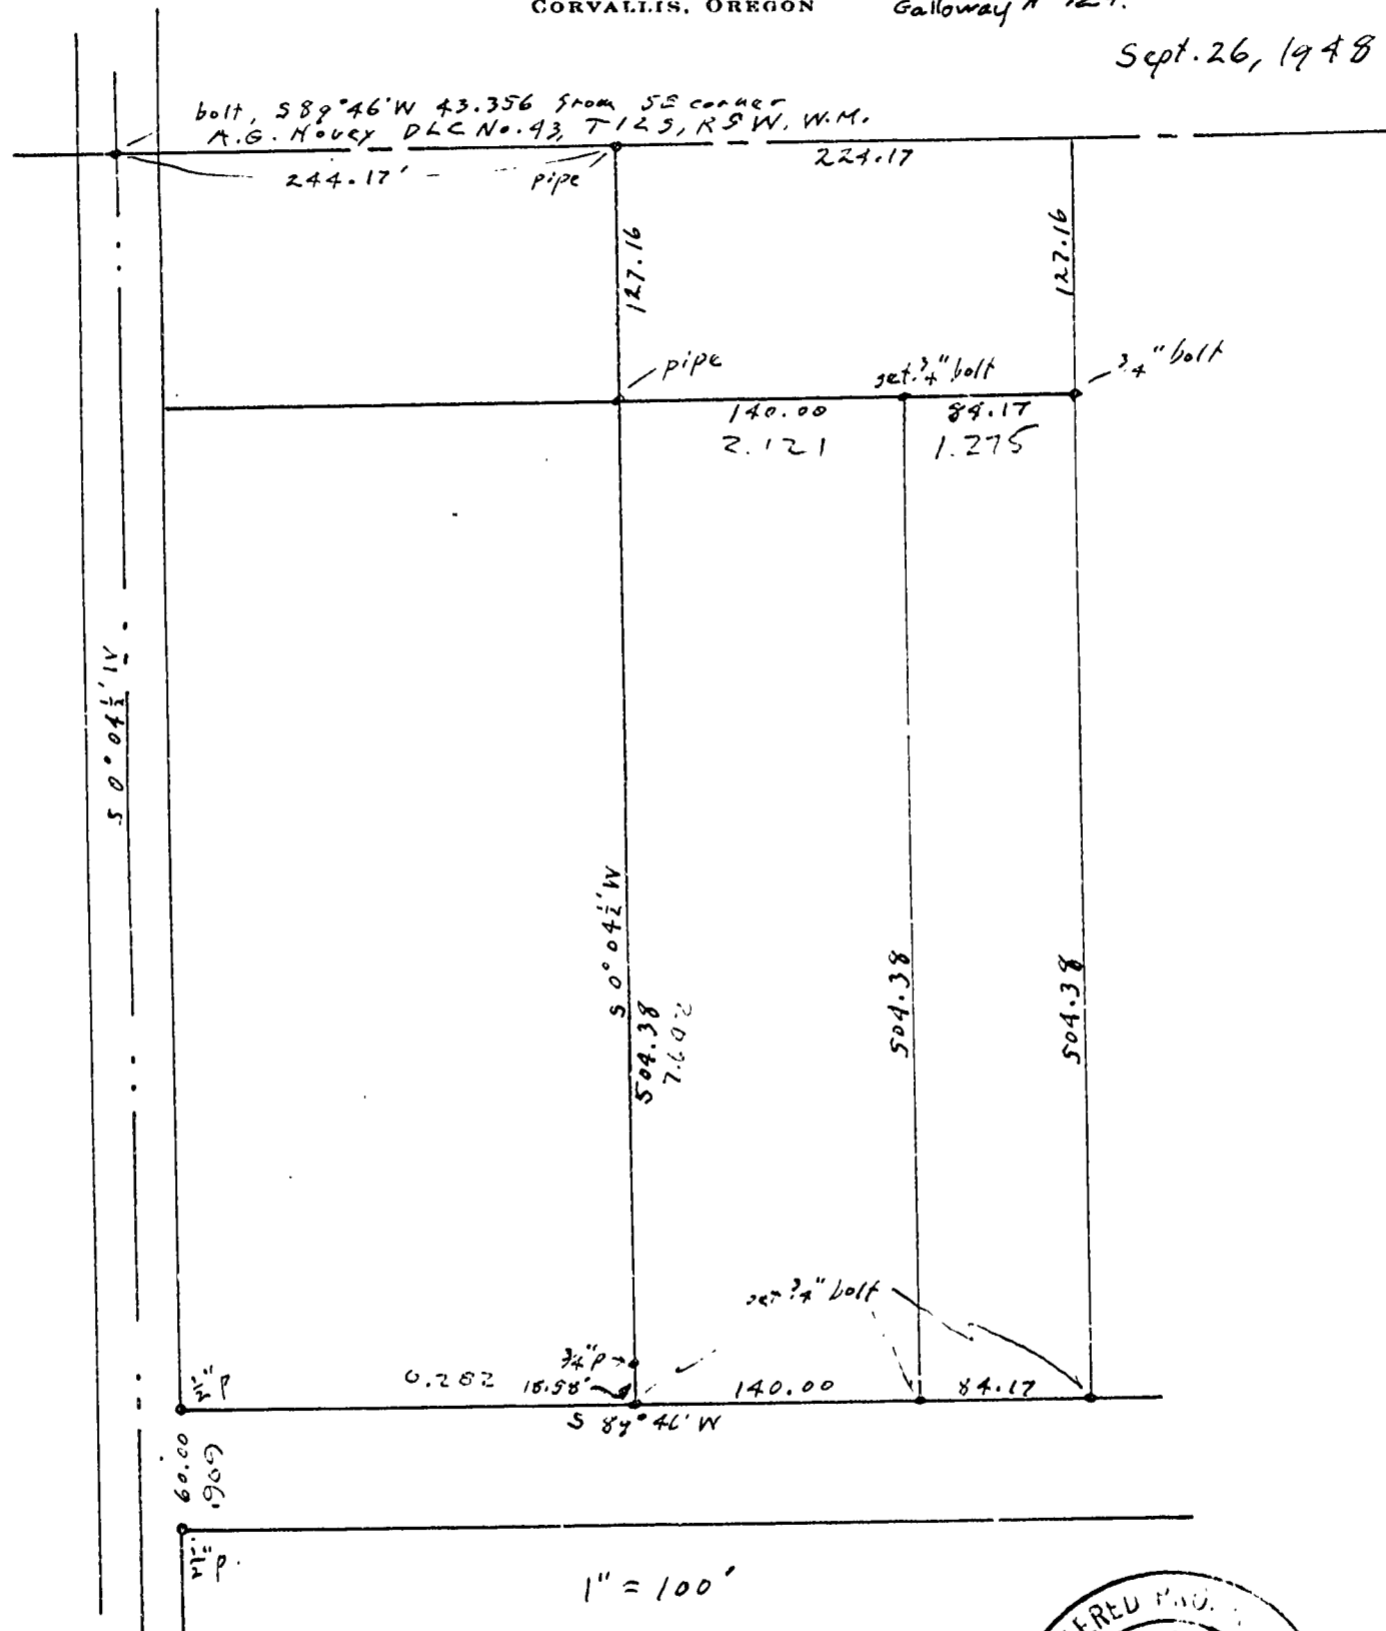

3.00
 3.39

