

1" = 6 CHAINS

Q49-14-6

---


AR Kyk      11-26-48

---

2055

LINE	DATE	PARTY
PROJECT		
4	350.90	-6°41'
3	187.35	-5°20'
2	74.79	+10°37'
1	400.05	-4°45'
	55.47	+3°12'
	54.05	+10°05'
	49-14-6	

R

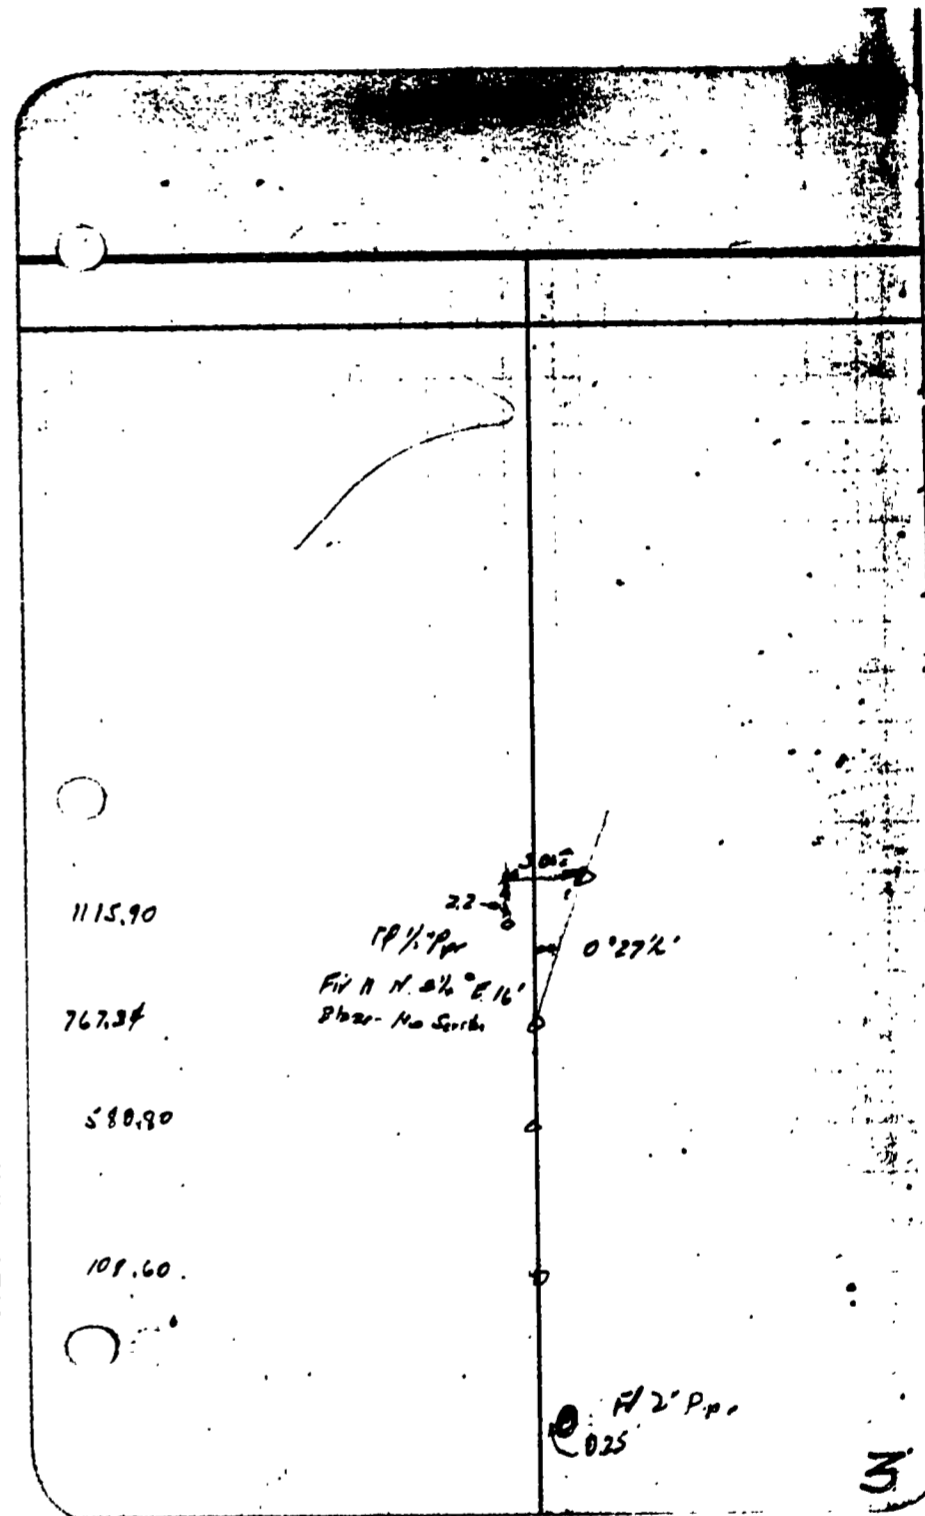

C.S. # 2055

REEL 11 FRAME 464

✓ Q49-14-6

AR Kyt

11-26-48

2055

LINE DATE \_\_\_\_\_ PARTY \_\_\_\_\_


PROJECT \_\_\_\_\_

NILMAN FORM P-1772

18821

4	350.95	-6°41'	2485L	R+2.80	✓	1115.90
3	187.35	-5°20'	18L.58			767.34
2	74.79	+10°37'	72.57			588.80
1	400.05	-4°43'	398.69			101.60
	55.47	+3°16'	55.38			
	54.05	+10°28'	53.22			

49-14-5

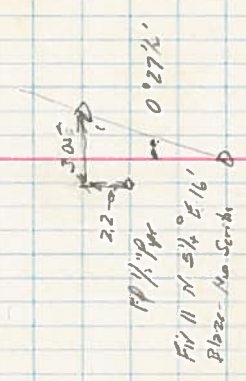

Fl 2' P.p.  
0.25