


OTTO H. MEYER  
CIVIL ENGINEER  
621 North 35th Street  
CORVALLIS, OREGON

21776

Dec. 28, 1948

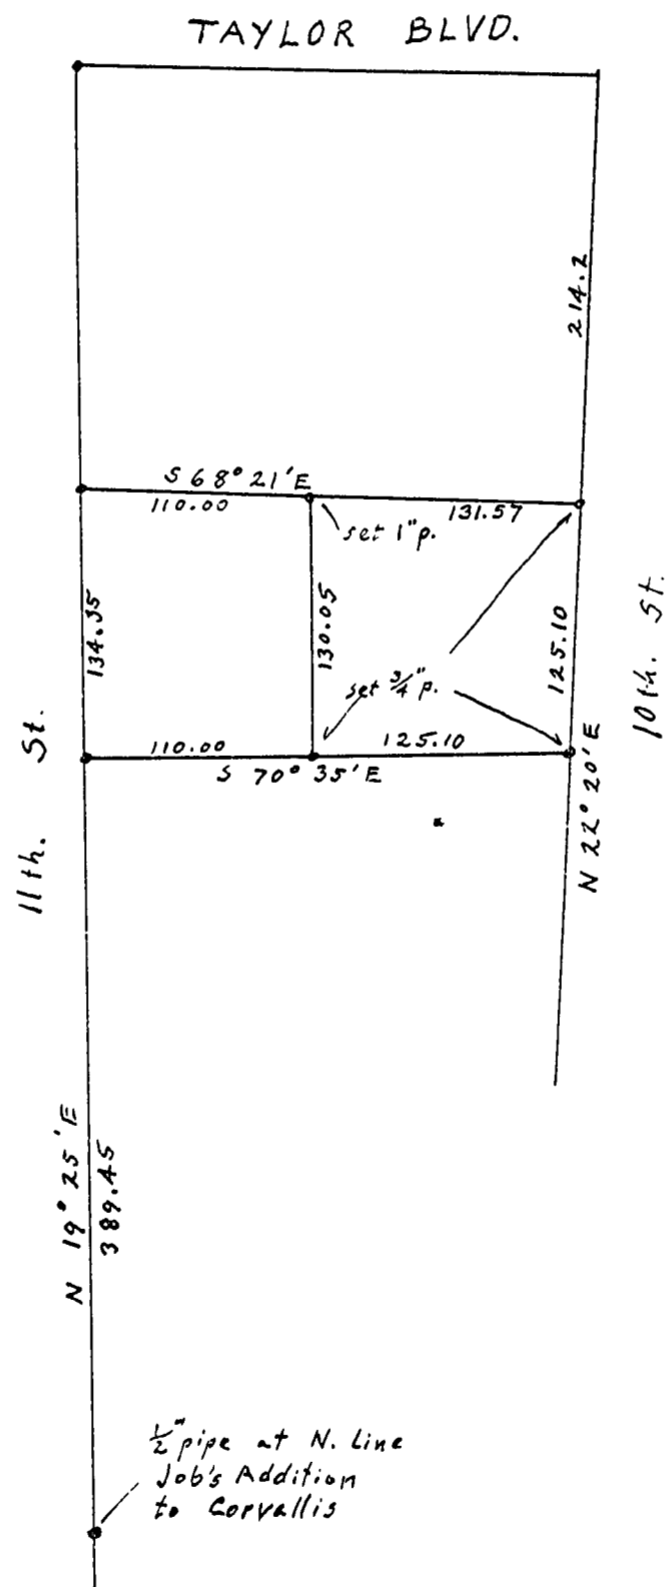

1" = 100'

