


C.S. # 2104

Philomath Farming Lots
Block 11

Block 11
Philomath

7-15-49
H. Wall.

For C A Minty

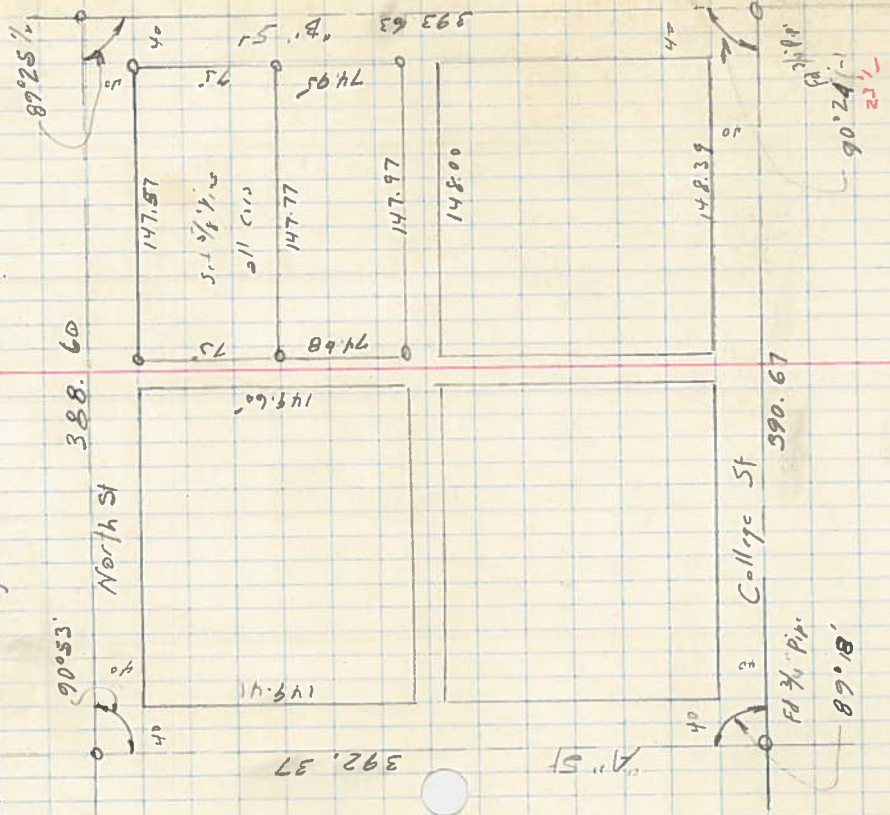

2104