

---

C.S. # 2107

Hardcopy 11-5 #18


also see notes in file

C1 48-11-5

C.S. # 129

2107

For J E Hicks

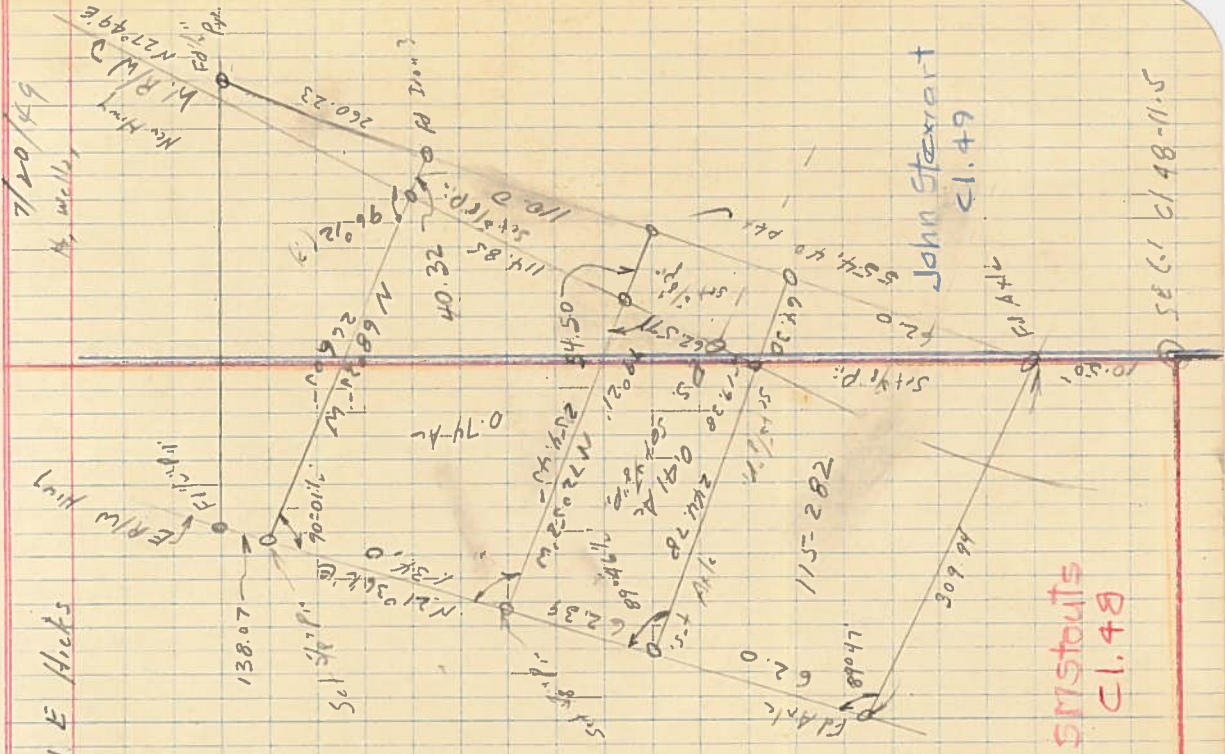

SM Stouits  
C1.48

SEC. 1 C148-11-5