


OTTO H. MEYER
CIVIL ENGINEER
621 North 35th Street
CORVALLIS, OREGON

2116

Apr. 30, 1949

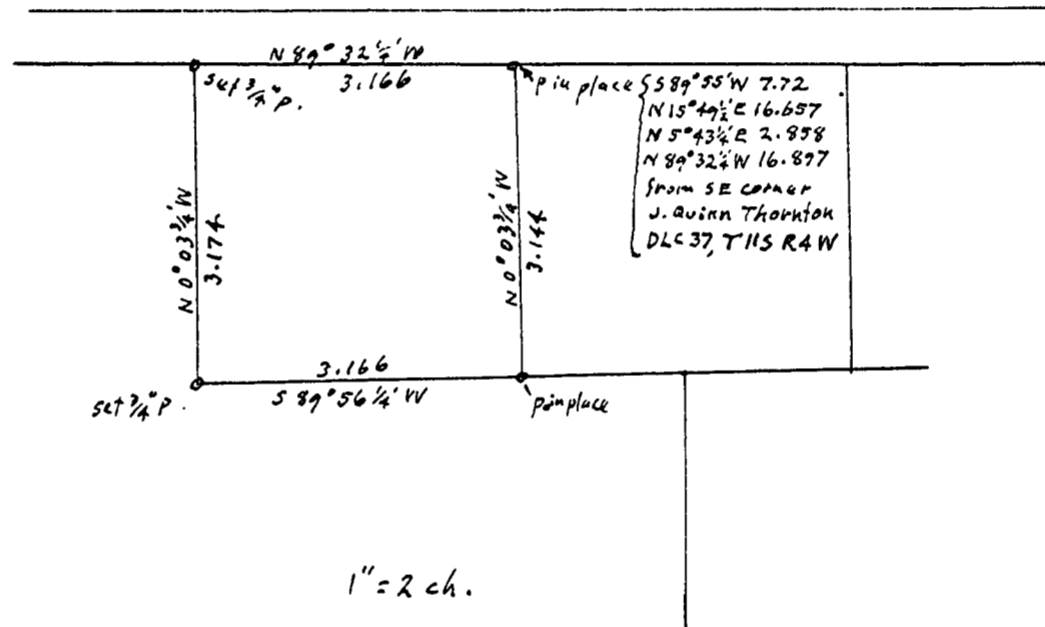

OTTO H. MEYER
CIVIL ENGINEER
821 North 85th Street
CORVALLIS, OREGON

2116

Apr. 30, 1949

