

C.S. # 2137

Hardcopy 12-6 #31

also see notes in file

C1 63-12-6

C.S. #197

For Benton Co

9-7-57
% + Paid

2137


22187

LINE DATE PARTY

PROJECT

BRANNON 41007

Dist	VA	Horiz	Offset	Net
302.00	+0°24'	302.00	Lt 14.18	236.84
277.40	+1°40'	277.26	Rt 173.20	
258.37	+2°15''	258.17	Rt 173.20	652.09
400.00	+1°08'	399.92		
370.53	-	370.53	Rt 173.20	770.53
400.00	-	400.00		
266.87	-	266.87	Rt 173.20	
149.70	-	149.70	Rt 173.20	549.70
400.00	-	400.00		
365.85	-	365.85	Rt 173.20	766.85
401.00	-	401.00		
187.29	-	187.29	Rt 173.20	71.27

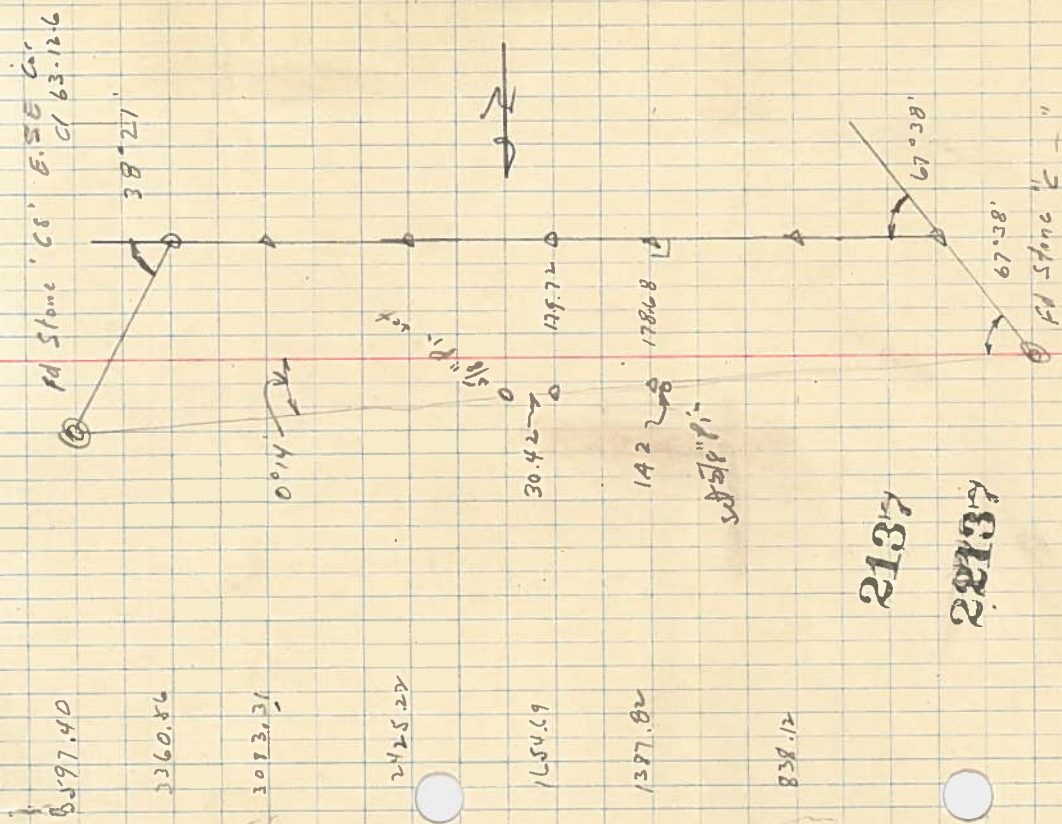

2137
22137