


OTTO H. MEYER  
 CIVIL ENGINEER  
 621 North 35th Street  
 CORVALLIS, OREGON

2149

Nov. 11, 1949

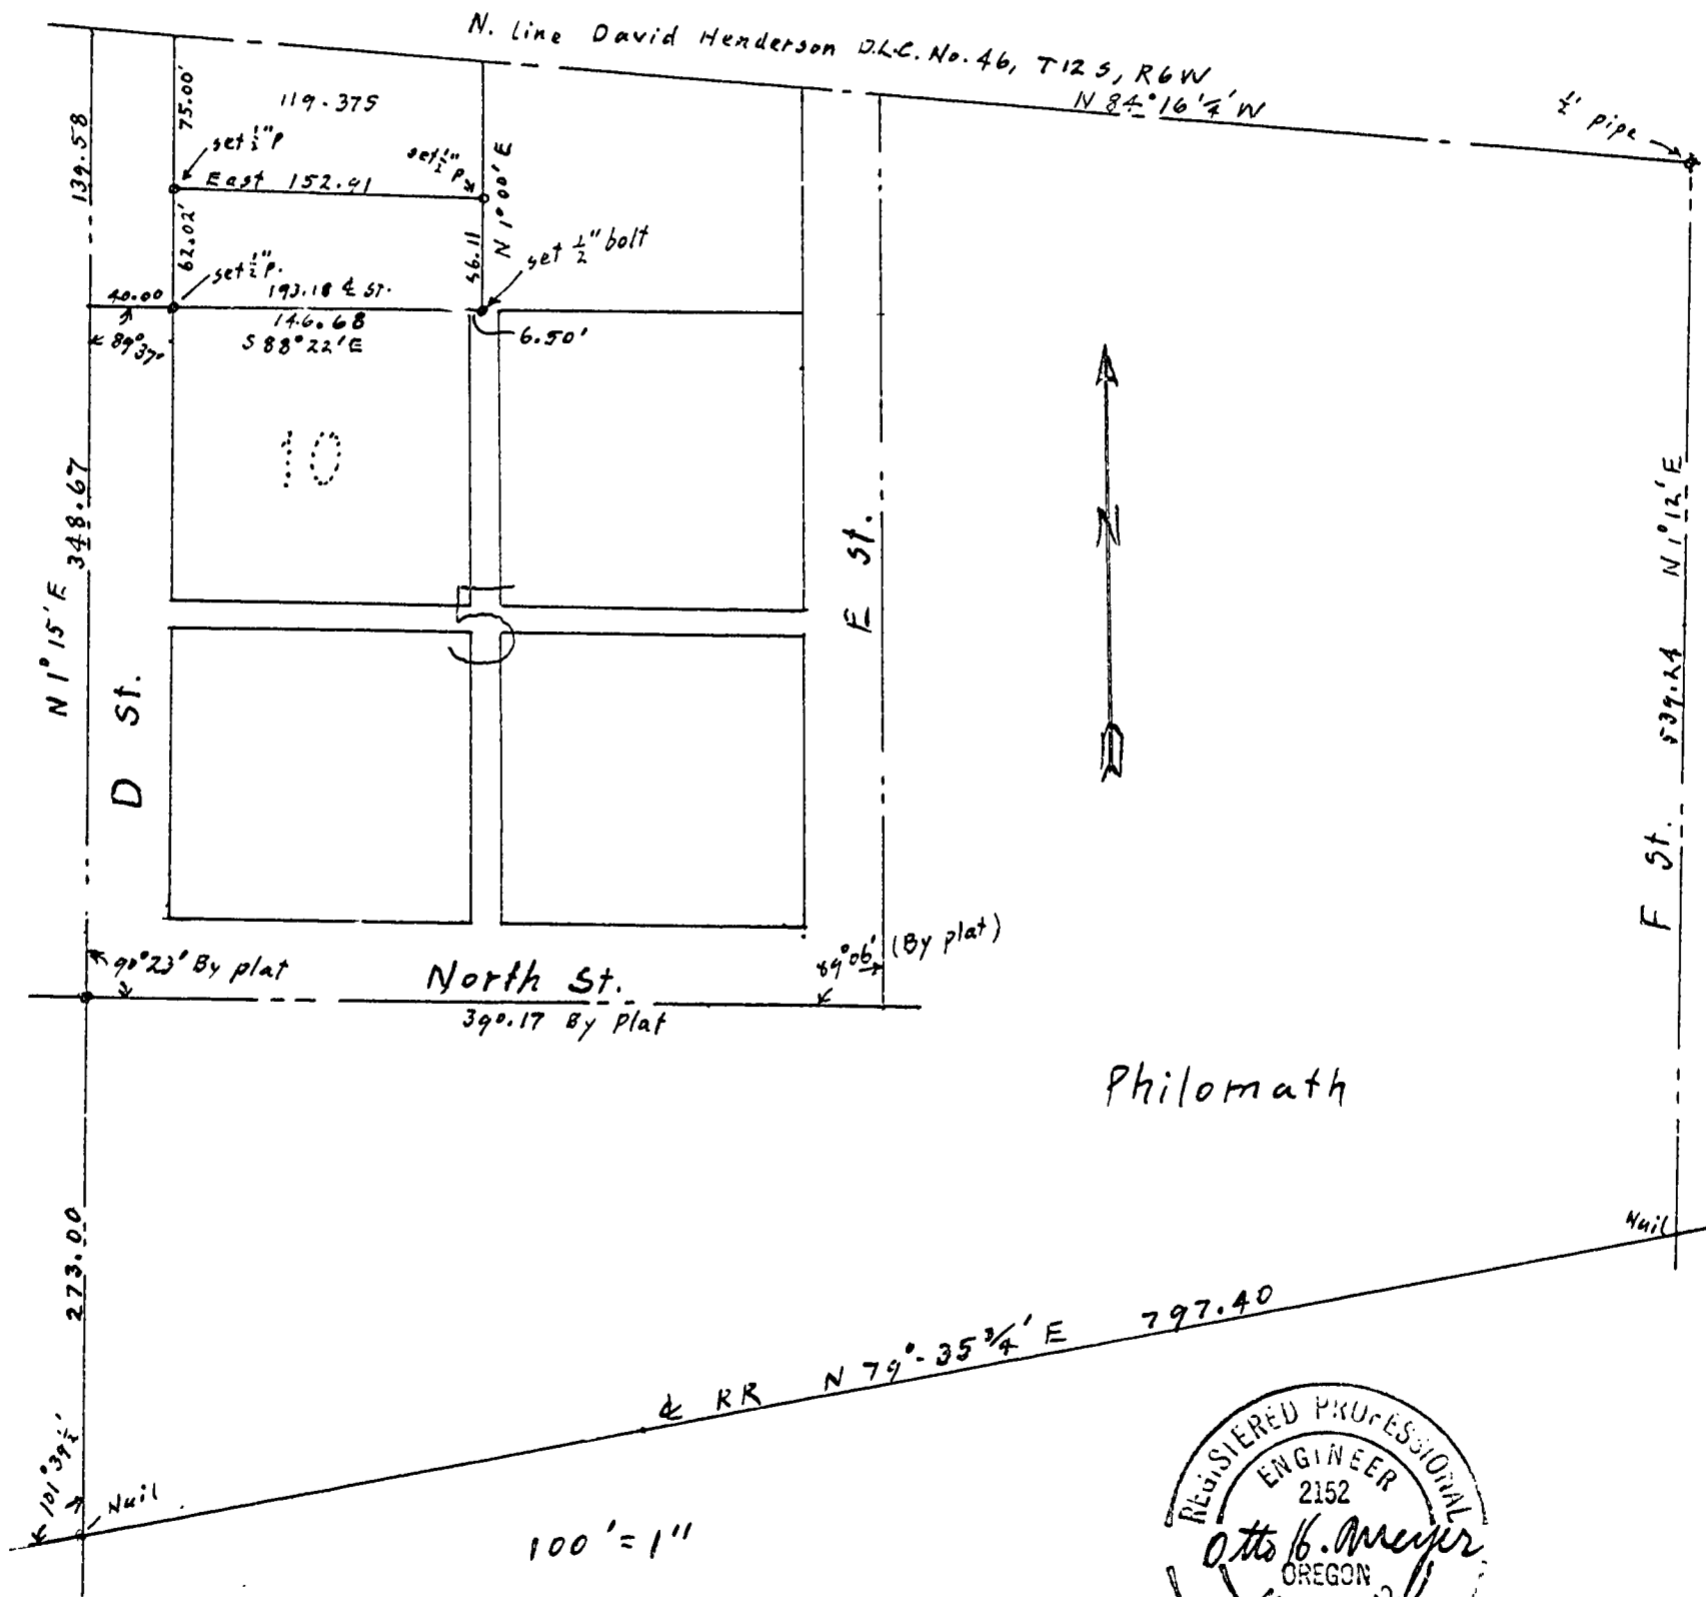

OTTO H. MEYER  
 CIVIL ENGINEER  
 621 North 35th Street  
 CORVALLIS, OREGON

2149

Nov. 11, 1949

