


OTTO H. MEYER
CIVIL ENGINEER
021 North 35th Street
CORVALLIS, OREGON

2122

Oct. 2, 1950

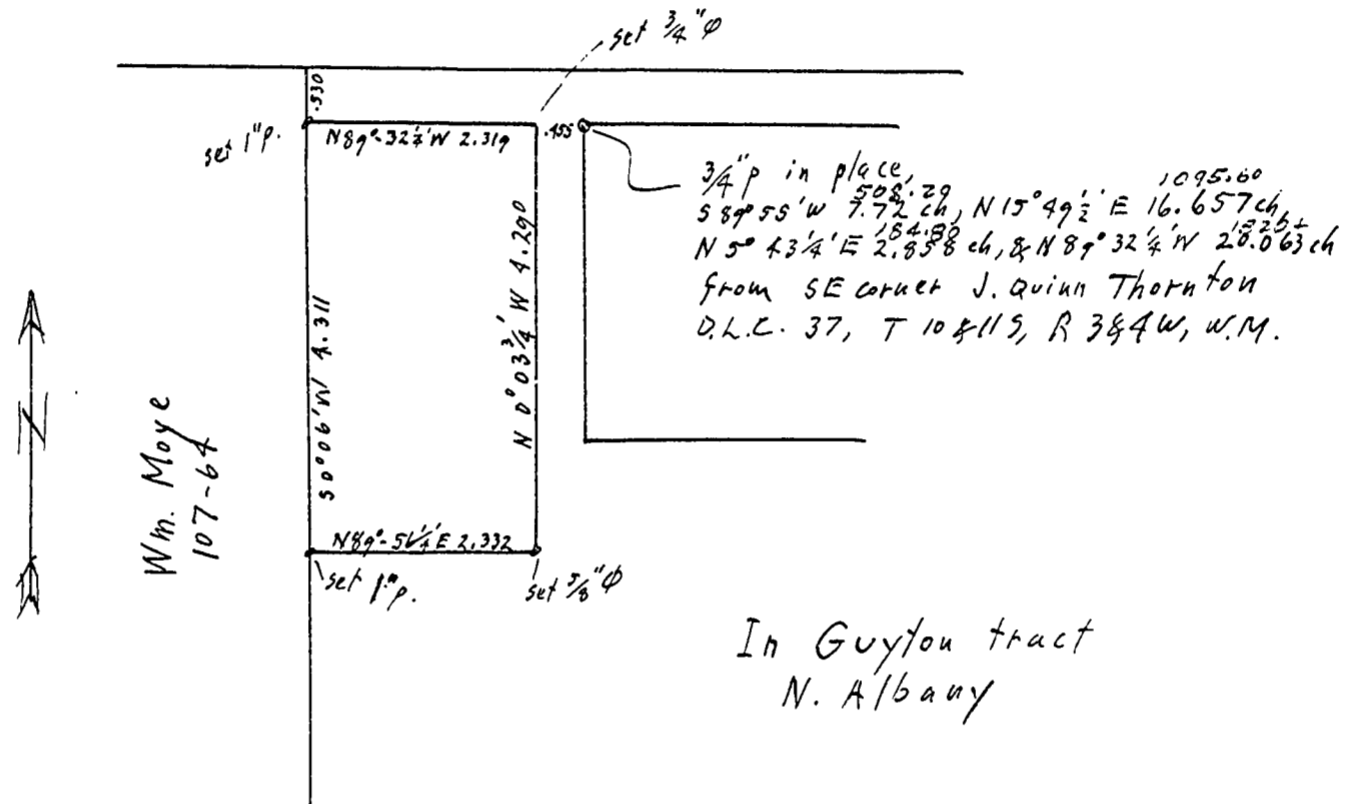

In Guyton tract
N. Albany

1" = 2 ch.

