


C.S. 2246

B-18

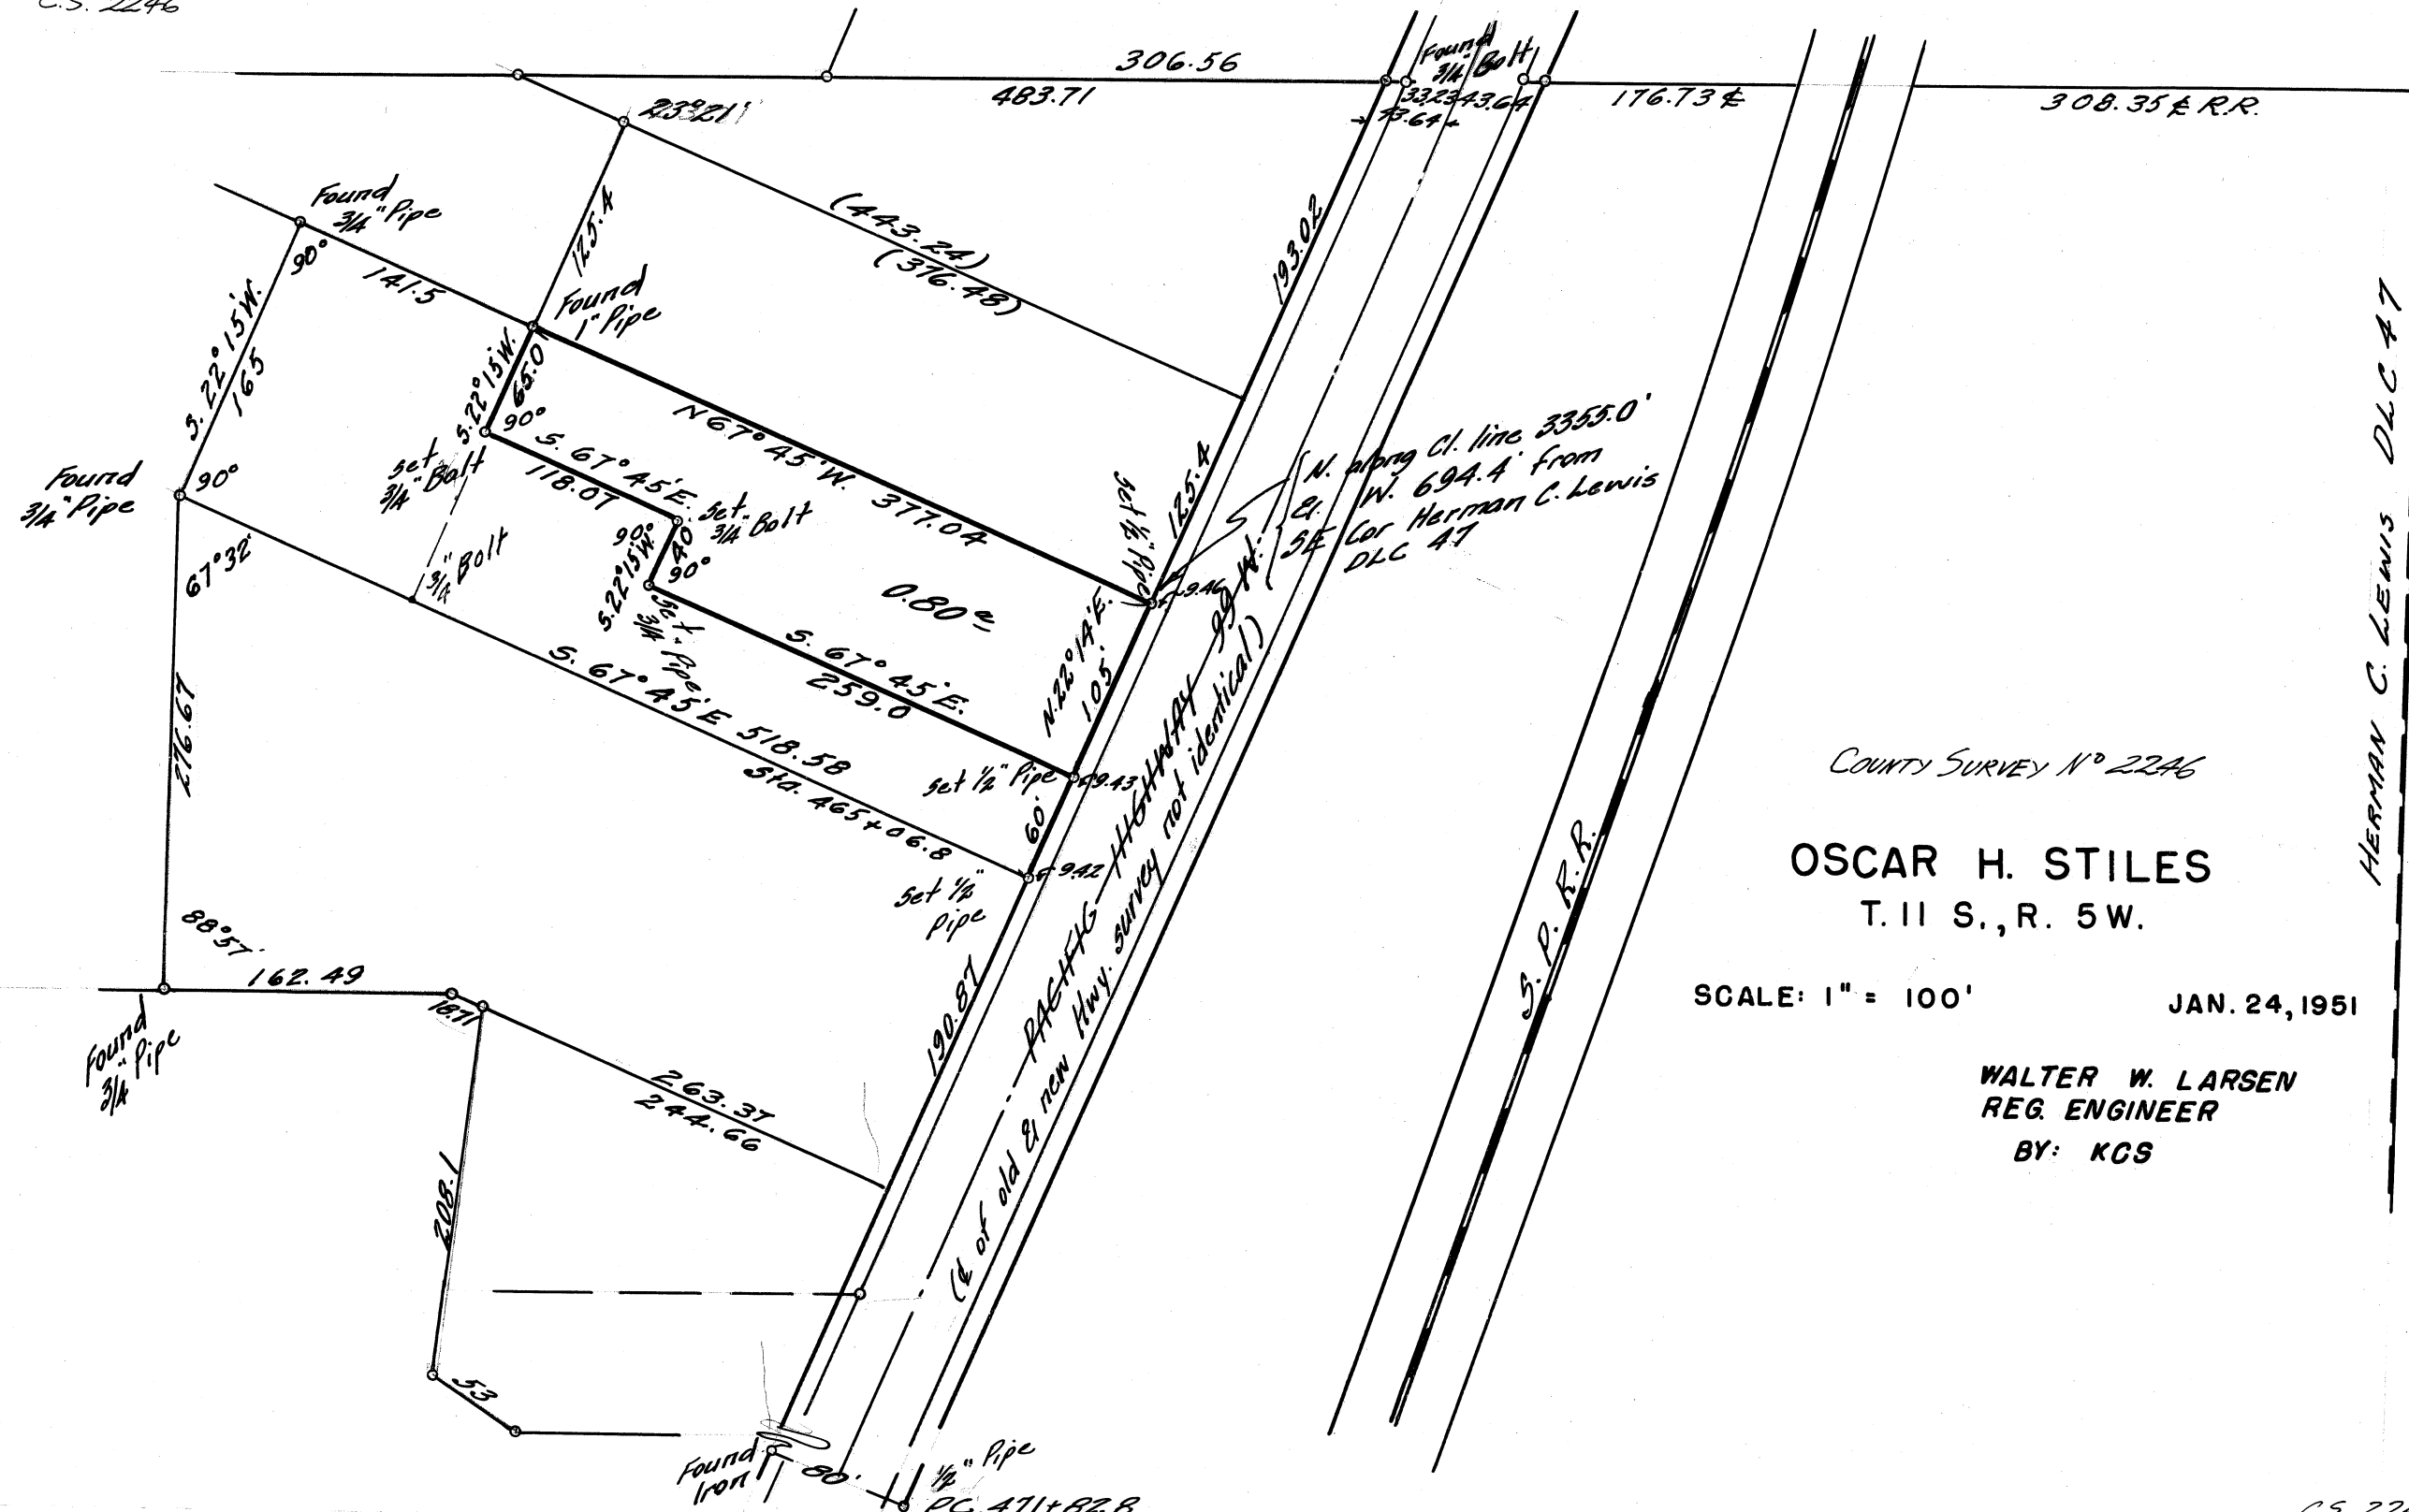

COUNTY SURVEY N° 2246

OSCAR H. STILES
T. 11 S., R. 5 W.

SCALE: 1" = 100'

JAN. 24, 1951

WALTER W. LARSEN
REG. ENGINEER
BY: KCS

HERMAN C. LEWIS DLCA 7