

C.S. # 2261

See notes in file

F.B.

Cl. 38-12-5  
CS #129

3-16-57  
Barker  
Zimark

Johnson

133-650

2261


Plotted on letter file  
sheet from C.H.H.M.



PROJECT \_\_\_\_\_  
 KILHAM FORM # 172  
 LINE DATE \_\_\_\_\_ PARTY \_\_\_\_\_

N/E cor Rod				180055
NW cor Rod	In $\angle$ 89° 50'	$\Delta_4$ to NE cor rod		
$\Delta_7$	268.88 - 6° 45'	267.02		
rod NW cor	In $\angle$ 89° 50'	$\Delta_4$ to $\Delta_7$		
fd 1" P	41.10 -	41.10		
$\Delta_8$	$\angle$ R + 12° 10 1/2'			
$\Delta_7$	31.45 + 1° 25'	319.35		
fd 1/2" rod	-	from $\Delta_6$		
$\Delta_7$	6.08 -			
$\Delta_7$	$\angle$ R + 93° 34'			
$\Delta_6$	196.80 -			
$\Delta_6$	-			
$\Delta_5$	315.95 -			
$\Delta_5$	325.82 - 0° 53'	325.78		
1/2" P	In $\angle$ E to N 90° 16'			
	113.55 W of 1/2" P - SE of Don...			on G/T

March 16 2  
 17 8  
 19 5  
 15 hrs

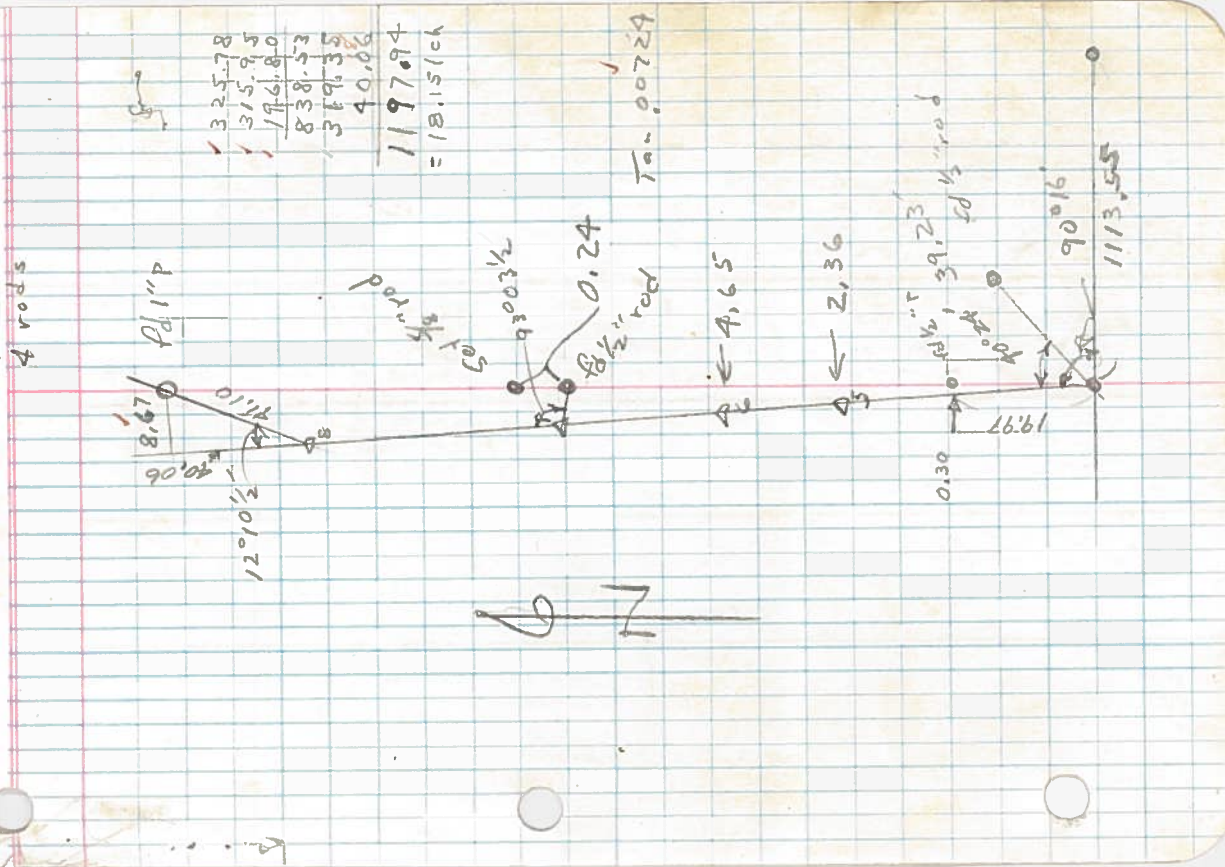

✓ 325.78  
 ✓ 315.95  
 ✓ 196.80  
 838.53  
 319.35  
 40.06  
 1197.94  
 = 18.151 ch

7.00724