


NO. 957
B 8

SURVEY FOR

L. M. GREEN

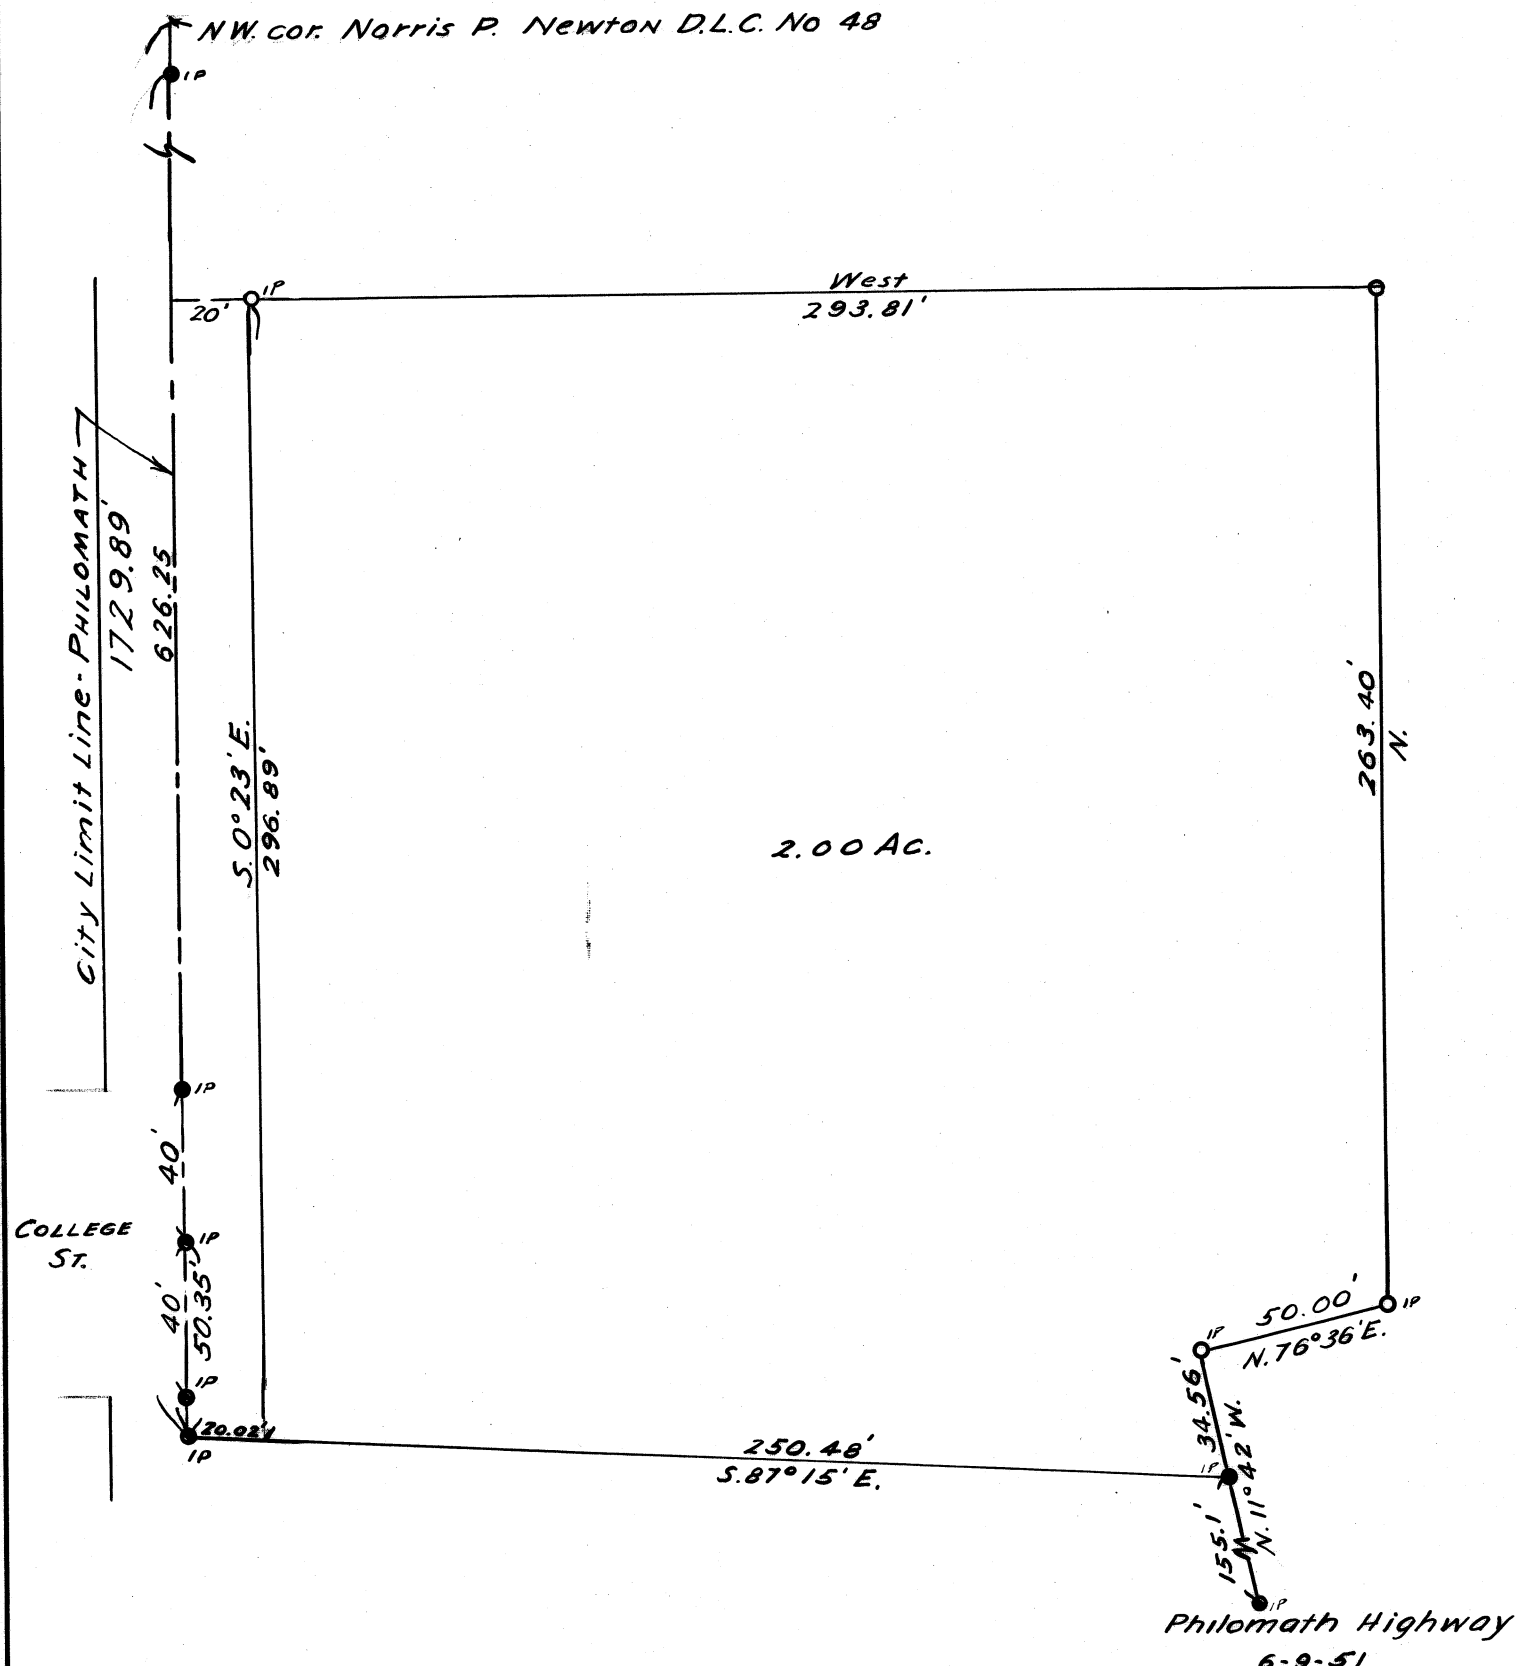

COUNTY SURVEY NO 2266

O DENOTES MONUMENTS SET

● DENOTES MONUMENTS FOUND

T 12 S R 6 W. WM. SEC. 12 CL. NO.
BENTON COUNTY
~~MARION COUNTY~~

OREGON

REGISTERED
OREGON
 LAND SURVEYOR

David F. Bates

JULY 7, 1944
DAVID F. BATES
 24

DAVID F. BATES RALPH G. BARNES
 LAND SURVEYORS
 SALEM, OREGON