


NO. 945
B-6

SURVEY FOR TRIPP & TRIPP

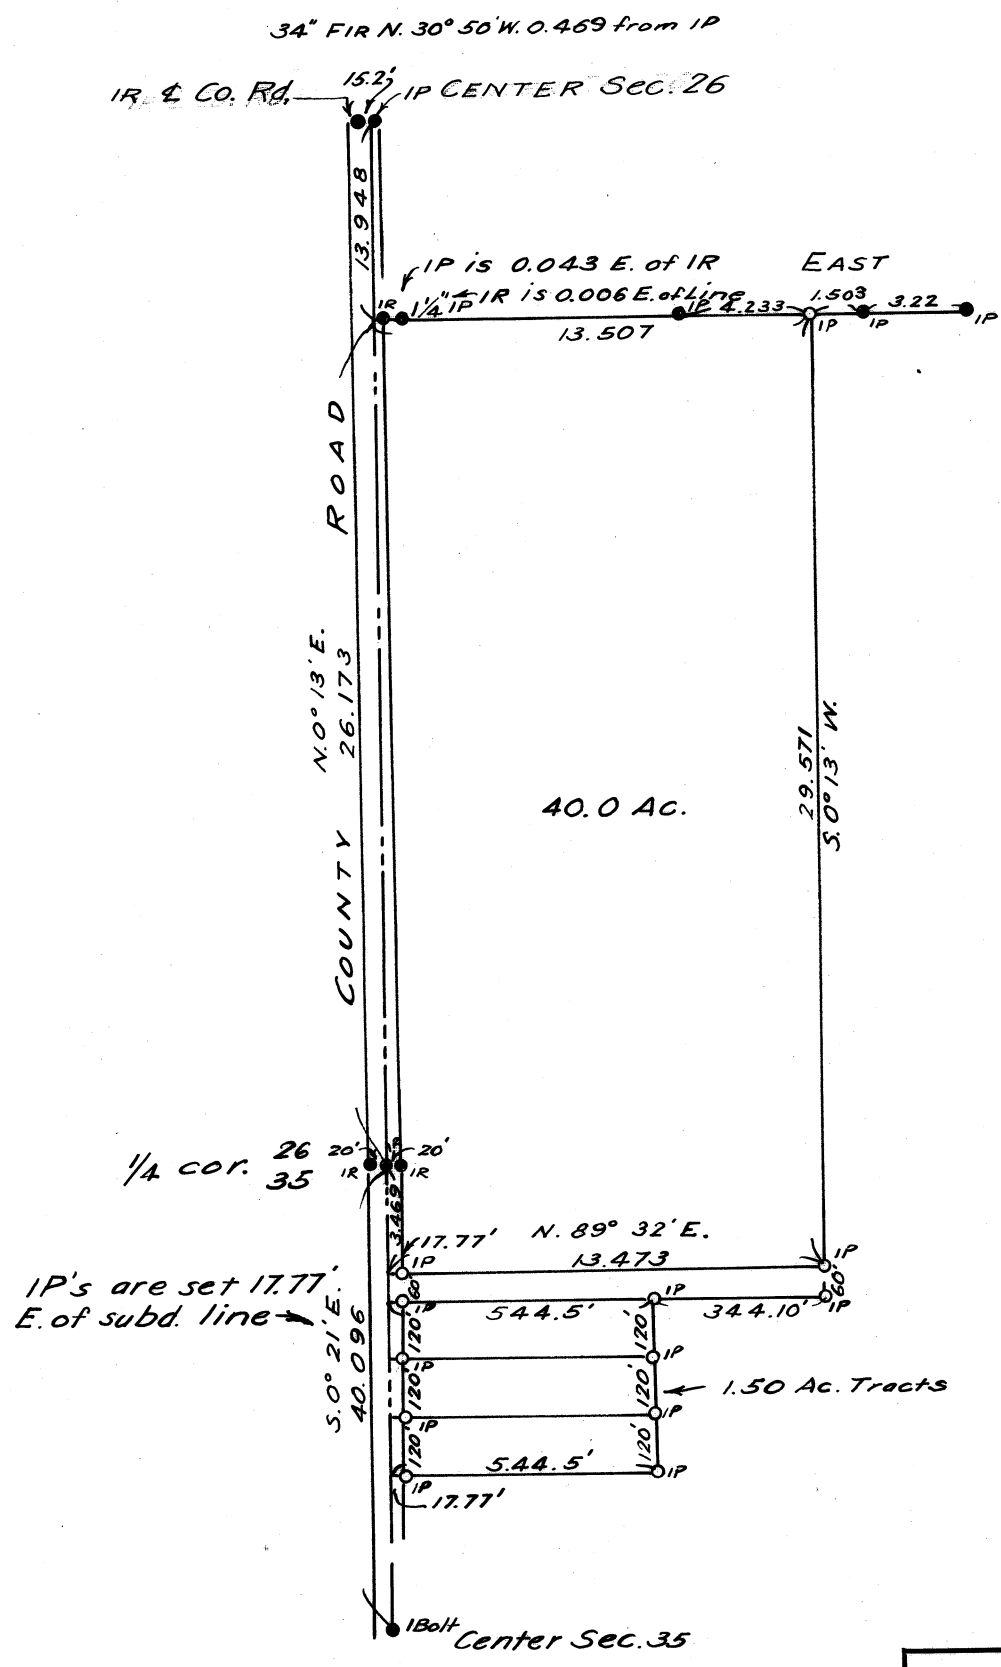

COUNTY SURVEY NO 2269

O DENOTES MONUMENTS SET ● DENOTES MONUMENTS FOUND

T 10 S R 4 W W M SEC. 26, 35 CL. NO.
 BENTON COUNTY
~~MARION COUNTY~~
 OREGON

4-26-51

REGISTERED
 OREGON
 LAND SURVEYOR

David F. Bates

JULY 7, 1944
 DAVID F. BATES
 24

DAVID F. BATES RALPH G. BARNES
 LAND SURVEYORS
 SALEM, OREGON