


C.S. # 2287

Rayburn's Addition  
Block 2



# Rayburns Addn Block 2

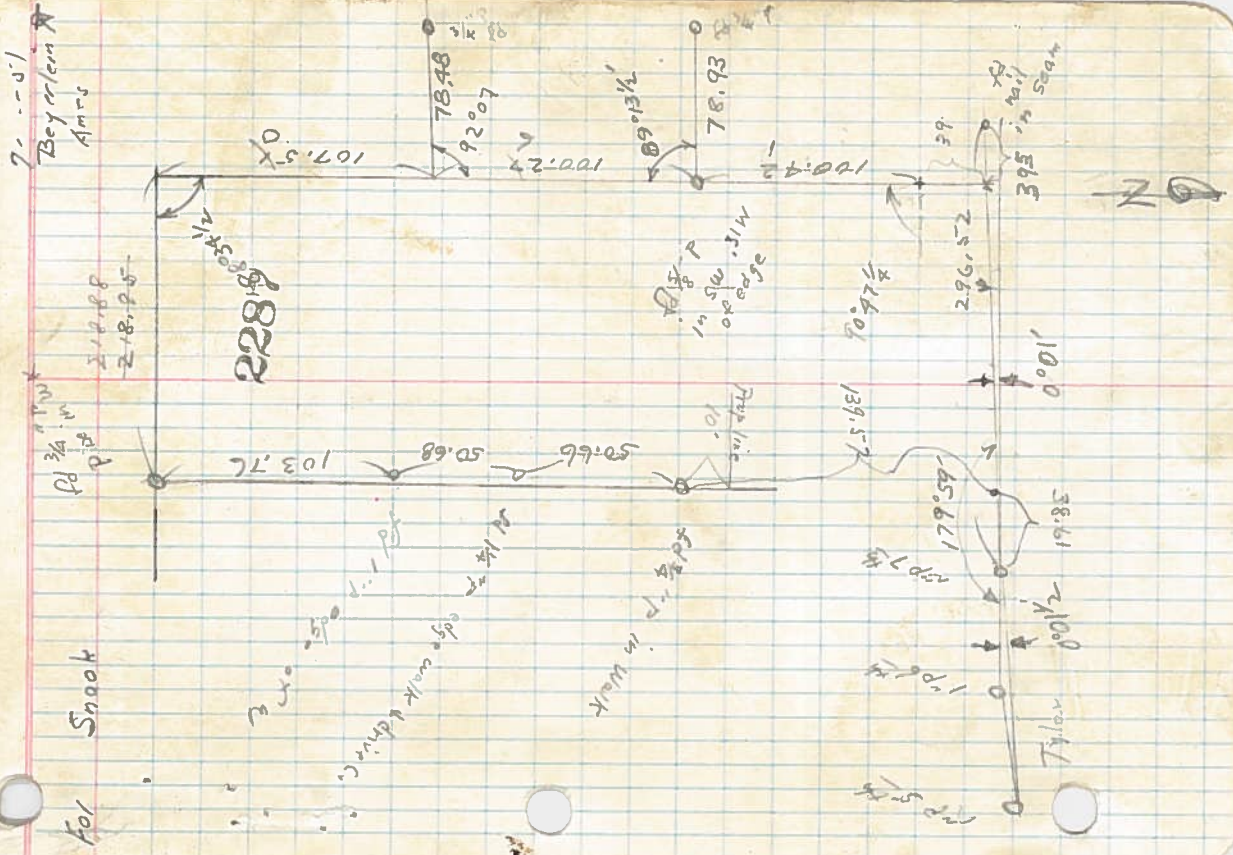

LINE DATE

PARTY

PROJECT

KILHAM FORM P.172 197286

4' offset  
line  
S. 52 s of SE BK P. in Cor. CU

T. SW BK 2  
Raytown

72.97

A


114.80

1/2 P. N. line  
Harrison

112.53

1/2 P. 9th  
Harrison

in walk  
N 0.70  
x 0.80  
x 0.10  
" 1.01

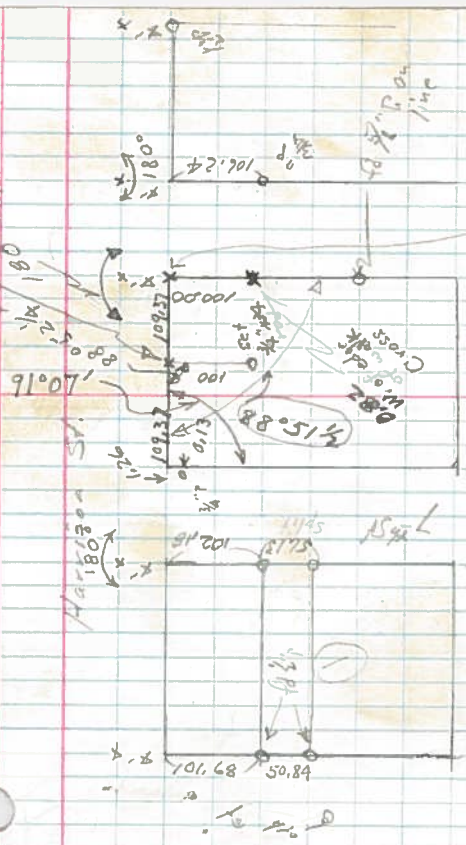

Cross  
edge  
0.84 W of walk  
0.14 S of  
seam E-W

88.51  
17.83