


C.S. # 2301

West Corvallis  
Block 4

F.B.

---




West. Corvallis  
Block 4

9-6-51  
Bejerholm  
Simp.

For Woodcock

2301

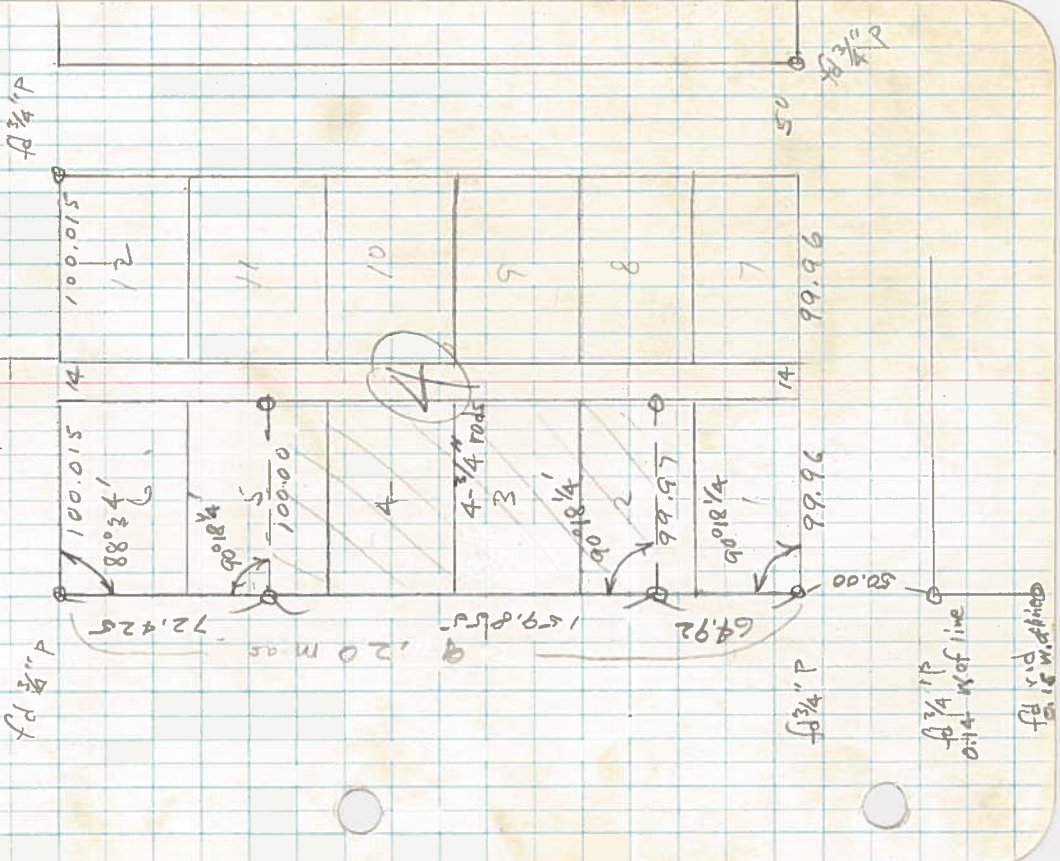

LINE DATE Sept 6, 1951

PARTY Beyerlein

PROJECT Woodcock in Block 4 West Cornwallis  
N 35 lot 3 all lot 3, 4 and S 1/2 Lot 5

4 rods

8 hours

3 miles